



AIA® Document G709™ – 2001

Work Changes Proposal Request

PROJECT *(Name and address):*

Great Work Montessori School
6001 West 16th Avenue
Lakewood, CO 80214

PROPOSAL REQUEST NUMBER: 006**DATE OF ISSUANCE:** January 20, 2016**OWNER:** ☒**ARCHITECT:** ☒**CONSULTANT:** ☒**CONTRACTOR:** ☒**FIELD:** ☐**OTHER:** ☐**OWNER** *(Name and address):*

Great Work, Inc.
5703 West 25th Avenue
Edgewater, CO 80214

CONTRACT FOR: General Construction**CONTRACT DATE:** January 2, 2015**FROM ARCHITECT** *(Name and address):*

Cunningham Group Architecture, Inc.
601 South Broadway, Suite N
Denver, CO 80209

ARCHITECT'S PROJECT NUMBER: 14-0744**TO CONTRACTOR** *(Name and address):*

Himmelman Construction, Inc.
12560 West Cedar Drive
Lakewood, CO 80228

Please submit an itemized proposal for changes in the Contract Sum and Contract Time for proposed modifications to the Contract Documents described herein. Within Zero (0) days, the Contractor must submit this proposal or notify the Architect, in writing, of the date on which proposal submission is anticipated.

THIS IS NOT A CHANGE ORDER, A CONSTRUCTION CHANGE DIRECTIVE OR A DIRECTION TO PROCEED WITH THE WORK DESCRIBED IN THE PROPOSED MODIFICATIONS.

DESCRIPTION *(Insert a written description of the Work):*

See attached.

ATTACHMENTS *(List attached documents that support description):*

See attached.

REQUESTED BY THE ARCHITECT:

(Signature)

Kari-elin Mock, AIA, NCARB, LEED AP BD+C

(Printed name and title)

Proposal Request (attachment to AIA Form G709)



PR No: **PR14-0744**
Date: **January 22, 2016**
Project: **Great Work Montessori School**
Owner: **Great Work Inc.**
Architect: **Cunningham Group**
Copy To: **File**

DESCRIPTION OF WORK

The purpose of the Proposal Request is to price the replacement of the columns at the covered walkways of the North and South Wings.

CHANGES TO CIVIL DRAWINGS:

Item No 01: Sheet C120

Revise Sheet C120 with the attached full size PDF.

Item No 02: Sheet C150

Revise Sheet C150 with the attached full size PDF.

Item No 03: Sheet C551

Revise Sheet C551 with the attached full size PDF.

**Cunningham Group
Architecture, Inc.**

601 South Broadway
Suite N
Denver, CO 80209

Tel: 303 861 1600
Fax: 303 861 1602

www.cunningham.com

CHANGES TO ARCHITECTURAL DRAWINGS:

Item No 01: Sheet A100

Revise Floor Plan to show new columns under existing covered walkway as shown per the attached full size PDF.

Item No 02: Sheet A200

Revise Roof Plan to show new columns gridlines and to **remove** fabric structures as shown per the attached full size PDF. Existing downspout ay courtyard needs to be relocated. Contractor to verify that proper slope is provided the whole length of the gutter.

Item No 03: Sheet A300

Revise Building Elevations to show new columns at covered walkways, and **remove** fabric structures, and delete existing crawlspace vents as shown per the attached full size PDF.

Item No 04: Sheet A810

Revise Reflected Ceiling Plan to show existing trimmed 2x beams, new columns and new beam under cover area per the attached full size PDF. Contractor to price the option of painting existing soffit and the option of adding new layer of fiber cement soffit underneath, replace vents and paint.

Item No 05: Sheet A900

Update 3d View as shown per the attached full size PDF.
Add Partial Section as shown per the attached full size PDF

CHANGES TO STRUCTURAL DRAWINGS:

Item No 06: S100 Revision made to arcade/courtyard area to incorporate permanent dropped steel frame below soffit and corresponding shallow pier foundations. Also added shallow piers to south side of building for new dropped steel frame structure and embedded steel posts for sign structure on Grids 18 & 19. New section cuts added to sheet for corresponding new foundations.

Item No 07: S200 Revision made to arcade/courtyard area to incorporate permanent dropped steel frame below soffit and corresponding shallow pier foundations. Added dropped steel beams below arcade structures to permanently support framing in these areas. New section cuts added to sheet for corresponding new framing details. Shade sails and related plan notes have been removed.

Item No 08: S300 Added details 9, 10, 11 and 12 to sheet to show foundations for new arcade steel structure, sign foundation at south elevation, as well as connection details of new dropped steel beams and columns at arcade structures.

ATTACHMENTS:

Civil Sheets: C120, C 150, C551

Architectural Sheets: A100, A200, A300, A810, A900

Structural Sheets: S100, S200, S300.

COMMENTS:


Initiated By:		Design Service	
<input type="checkbox"/> Owner	<input type="checkbox"/> Architect	<input type="checkbox"/> Original Scope	<input checked="" type="checkbox"/> Revised Scope
<input type="checkbox"/> Contractor	<input type="checkbox"/> Consulting Engineer		

END OF PR 06

ET O MONTESSORI ISC

6015 EST 16T EN
OO CO O 80214

JSELL CYNTHIA
BROWN JASON
DETAILS:
39-363-09-009
HEDULE: 058892

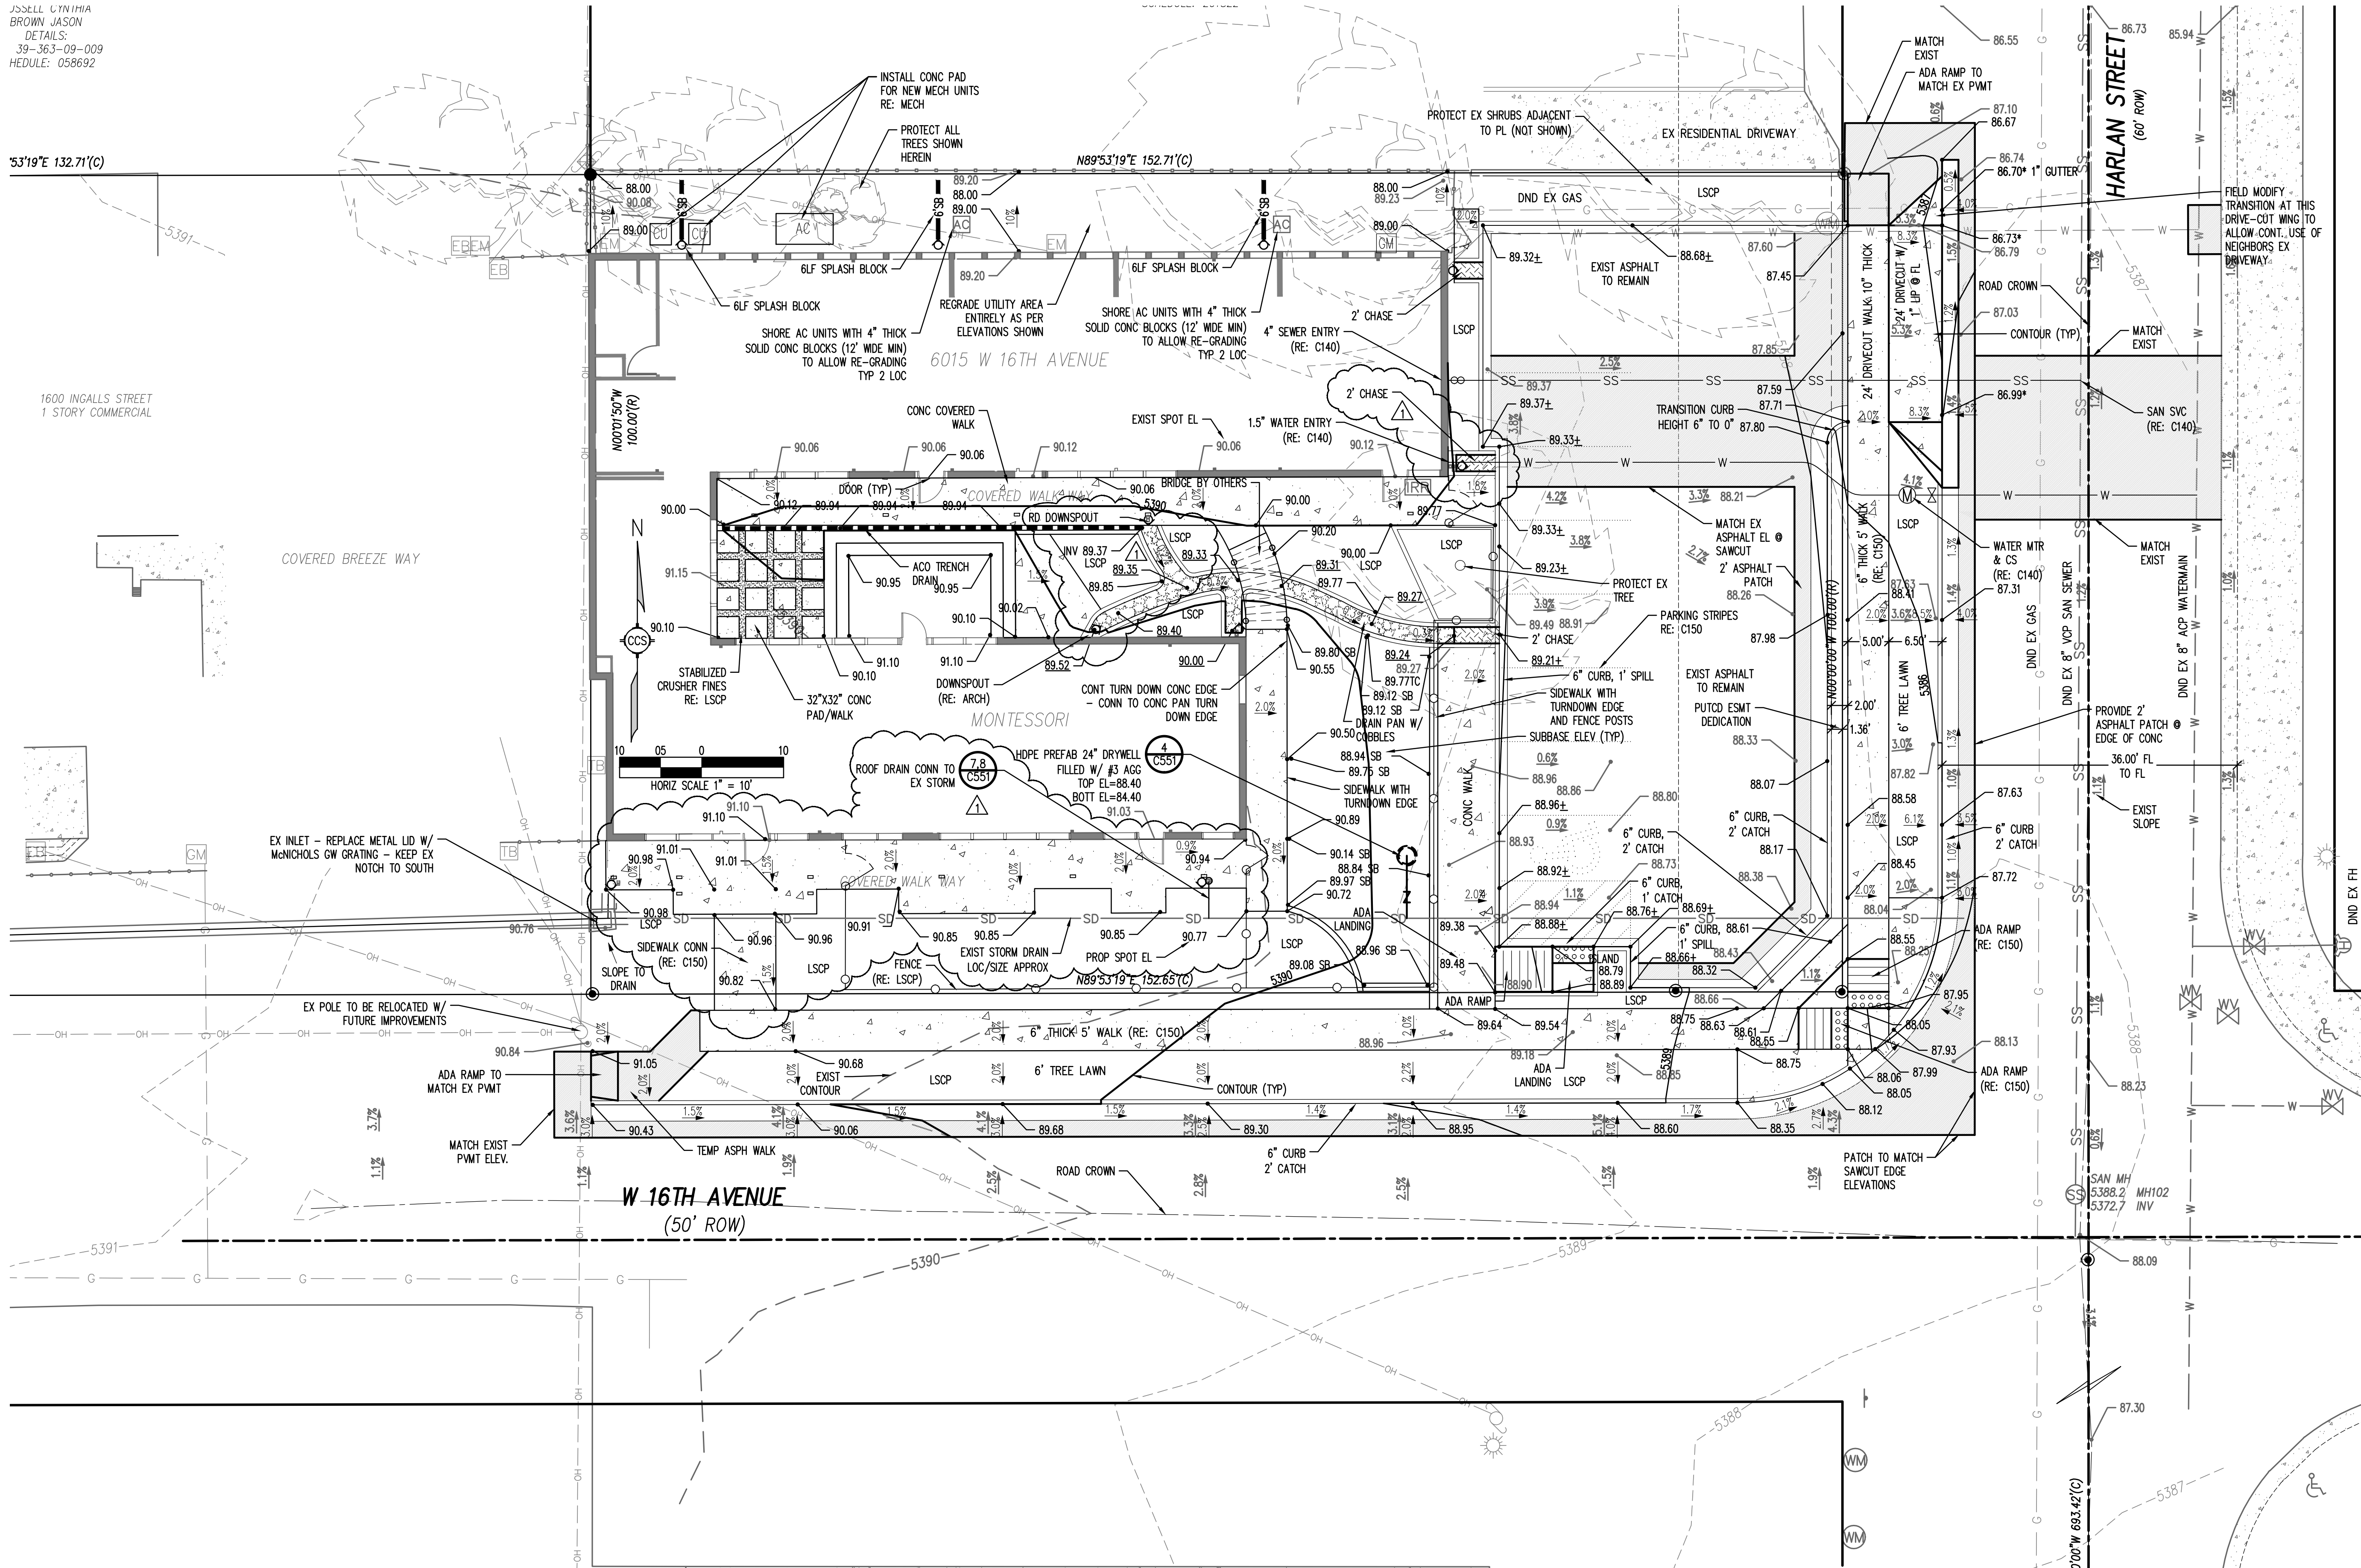

TOTAL AREA OF DISTURBANCE: 15,477 SF
TOTAL CONSTRUCTION AREA: 20,523 SF
SEEDING AREA: SEE LANDSCAPE PLANS
RECEIVING WATERS: SLOANS LAKE

UTILITY NOTIFICATION
CENTER OF COLORADO
811
CALL 2-BUSINESS DAYS IN ADVANCE
BEFORE YOU DIG, GRADE, OR EXCAVATE
FOR THE MARKING OF UNDERGROUND
MEMBER UTILITIES

THE LOCATION OF UTILITIES SHOWN ON THE DRAWINGS HAVE BEEN
DETERMINED FROM RECORD DRAWINGS. THERE MAY BE OTHER
UTILITIES NOT SHOWN ON THE DRAWINGS WHICH PRESENTLY EXIST IN
THE AREA OF CONSTRUCTION. THE CONTRACTOR IS TO VERIFY
LOCATION AND GRADE OF ALL EXISTING UTILITIES IN THE VICINITY
PRIOR TO BEGINNING WORK. THE CONTRACTOR SHALL COORDINATE
AND PROVIDE FOR THE PROTECTION OF CONFLICTING UTILITIES. THE
ENGINEER AND/OR OWNER ASSUMES NO RESPONSIBILITY FOR THE
ACCURACY OR COMPLETENESS SHOWN.

BASIS OF BEARINGS:
AN ASSUMED BEARING OF N00°00'00"E FOR THE EAST LINE OF THE
SE1/4 SW1/4 OF SECTION 36, MONUMENTED AS SHOWN HEREON.

BASIS OF ELEVATIONS:
A PUBLISHED NAVD88 ELEVATION OF 5354.70 FOR THE CDD
BENCHMARK 828, BEING A BRASS CAP FOUND AT THE SOUTHEAST
CORNER OF COLFAX AVENUE & SHERIDAN STREET, NOT SHOWN.

ENGINEERING APPROVAL
CITY OF LAKEWOOD

REVIEW IS ONLY FOR GENERAL COMPLIANCE WITH LAKEWOOD
ENGINEERING STANDARDS AND REQUIREMENTS. ALL
RESPONSIBILITY FOR EXISTING CONDITIONS, CORRECTNESS OF
DIMENSION, DETAILS, CONCEPTS, QUANTITIES AND SAFETY
DURING CONSTRUCTION SHALL REMAIN WITH THOSE DESIGNING,
DEVELOPING AND CONSTRUCTING THE PROJECT.


CITY ENGINEER DATE:

Sheet Title
GRADING
PLAN

Sheet Number

C120

Copyright © 2015 by Cuningham Group Architecture, Inc. (All Rights Reserved)

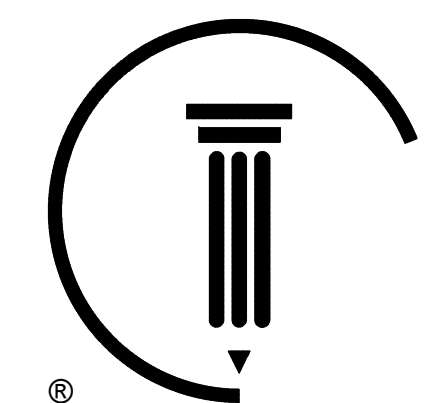

CUNINGHAM
GROUP

Cuningham Group
Architecture, Inc.

601 South Broadway
Suite N
Denver, CO 80209

Tel: 303.861.1600
Fax: 303.861.1602

www.cuningham.com

Consultant



CREATIVE
CIVIL SOLUTION
940 Kimbark Street, Suite 2
Longmont, Colorado 80501
303-684-8484

Revisions		
No.	Date	Description
1	7-10-15	Coord Set
2	7-17-15	Fire Dept
3	8-03-15	Civil 1
4	10-29-15	Civil 2
5	11-08-15	Civil 3
6	01-22-16	PR#06

Document Phase: Construction Documents

Date: June 17, 2015

PIC/AIC: PH

Drawn By: JRL

Checked By: CWK


Comm. No.: CCS# 15003

Project Title

Great Work Montessori
School

□□E□T□□O□□MONTESSO□ISC□OO□

6015 EST 16T EN EE
□□E□OO□CO□□□O 80214

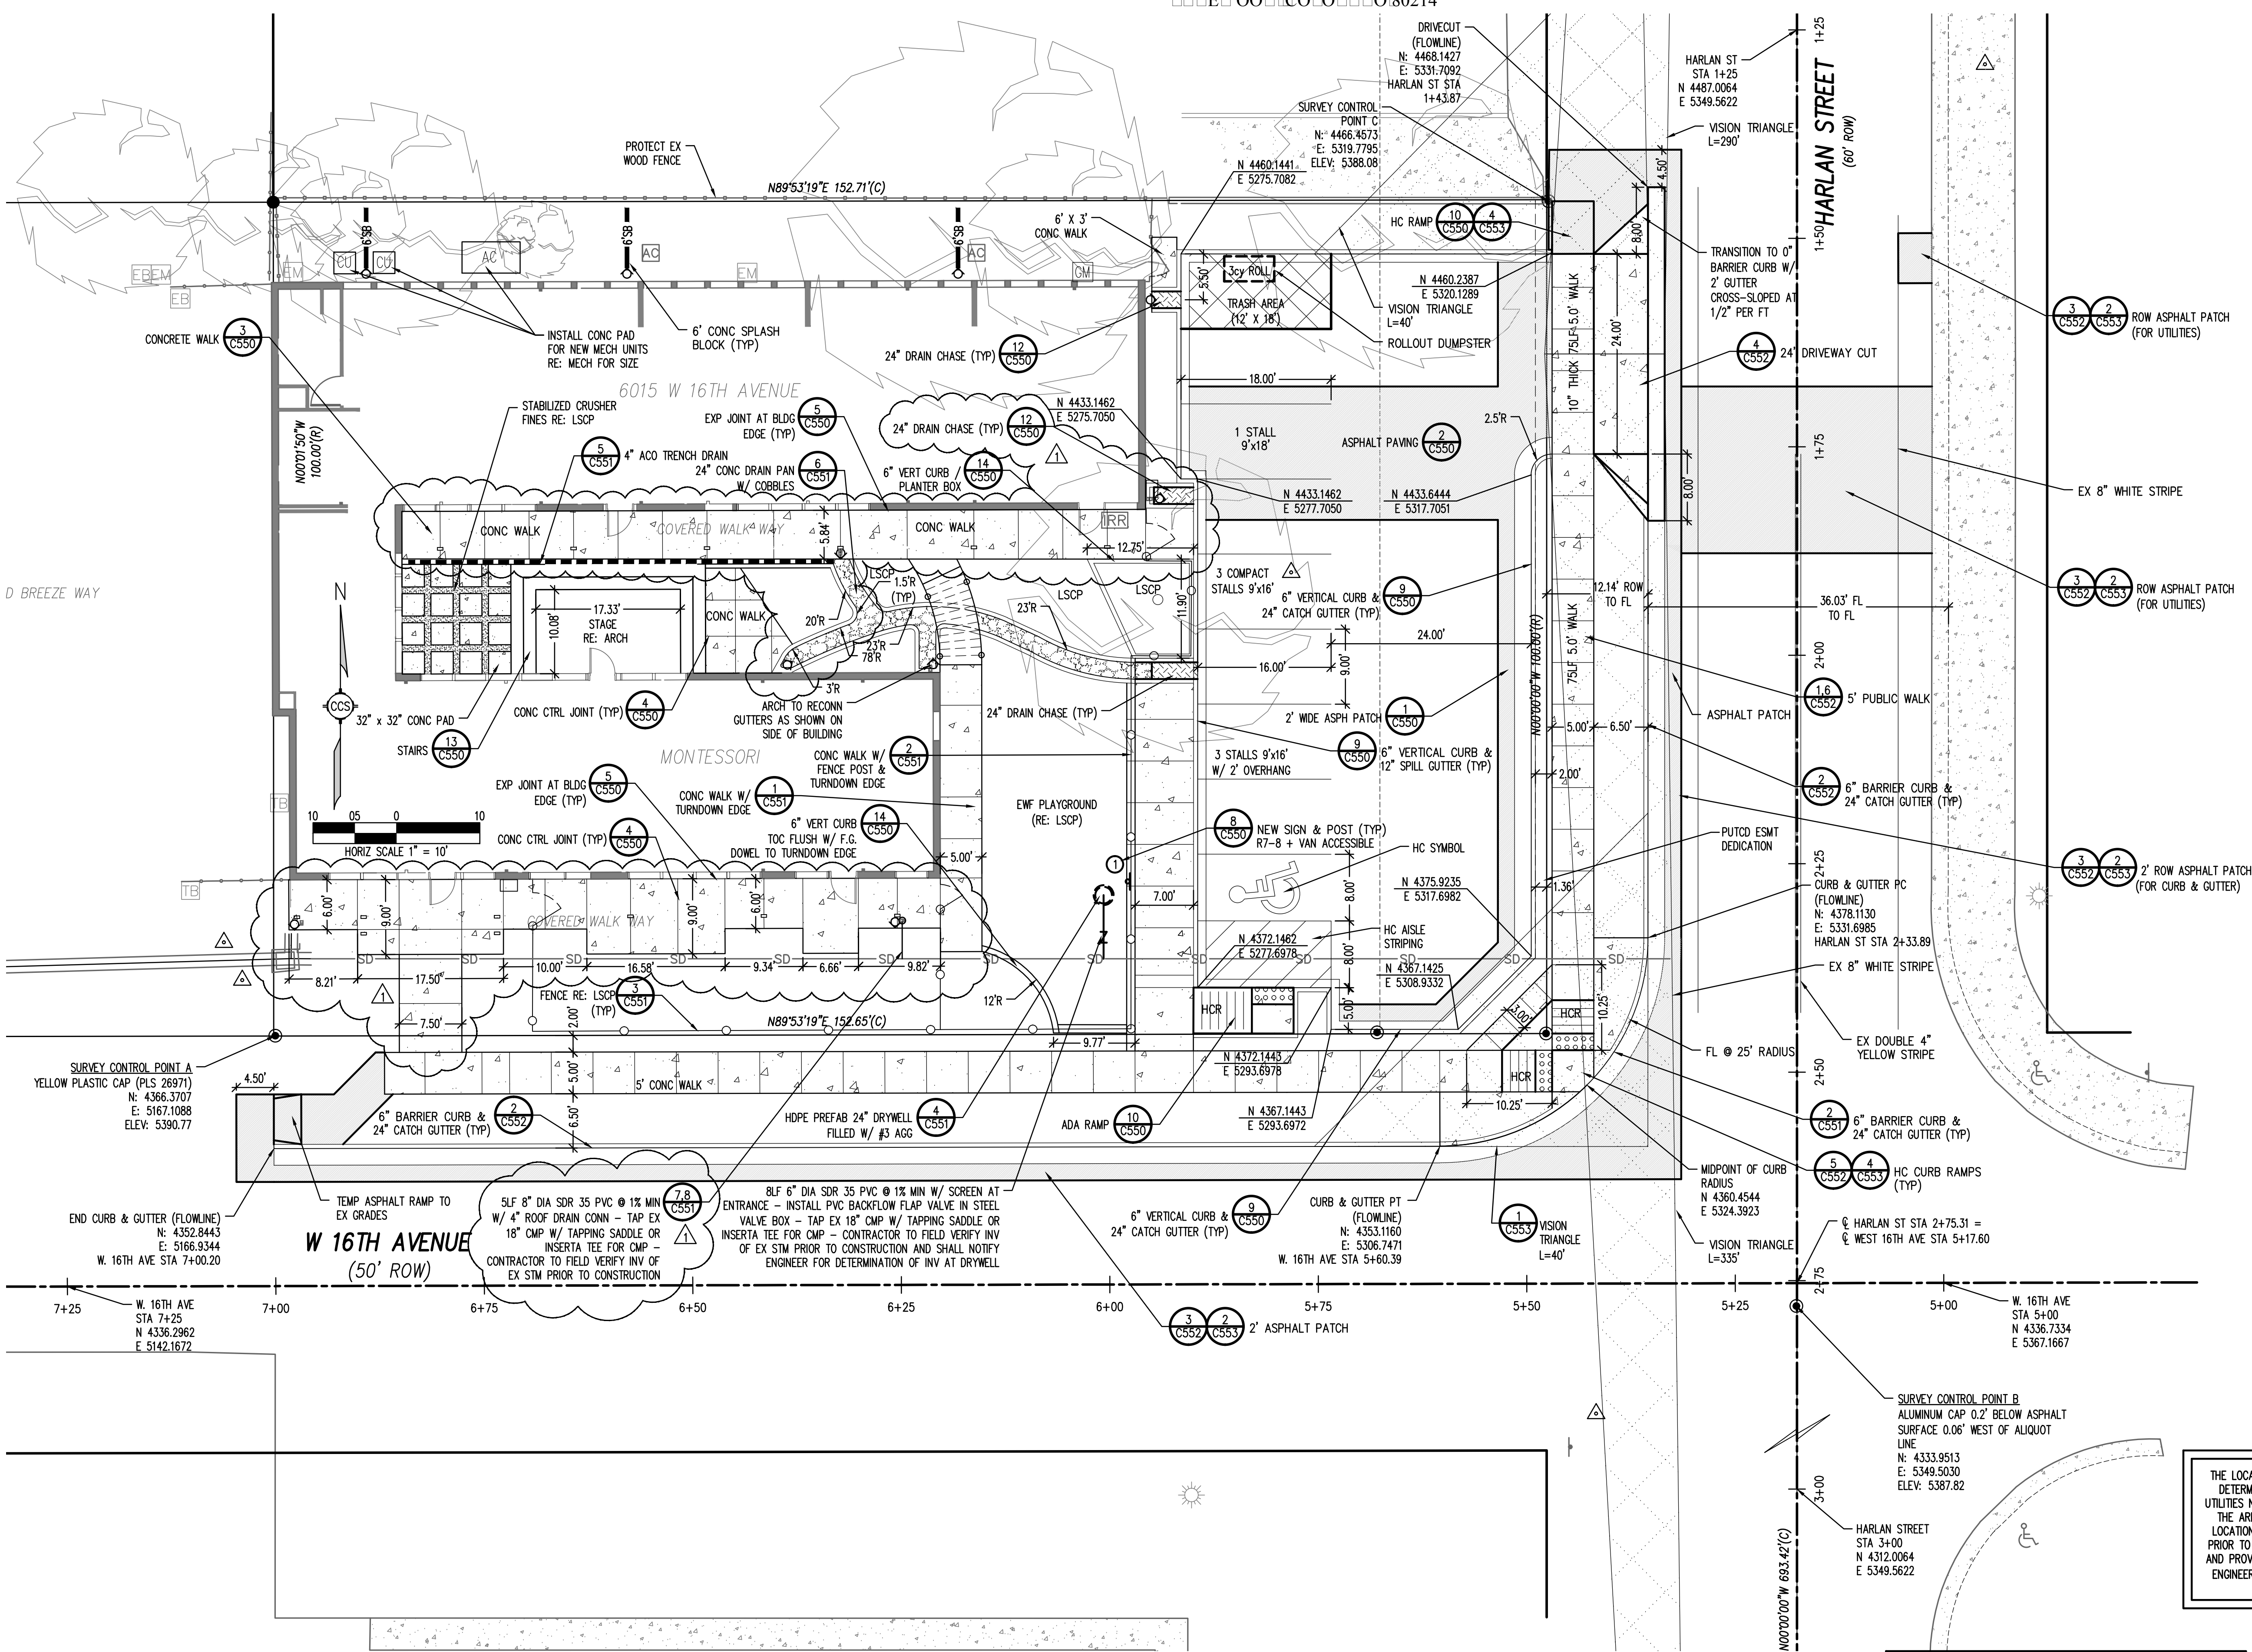


UTILITY NOTIFICATION
CENTER OF COLORADO
811
CALL 2-BUSINESS DAYS IN ADVANCE
BEFORE YOU DIG, GRADE, OR EXCAVATE
FOR THE MARKING OF UNDERGROUND
MEMBER UTILITIES

THE LOCATION OF UTILITIES SHOWN ON THE DRAWINGS HAVE BEEN
DETERMINED FROM RECORD DRAWINGS. THERE MAY BE OTHER
UTILITIES NOT SHOWN ON THE DRAWINGS WHICH PRESENTLY EXIST IN
THE AREA OF CONSTRUCTION. THE CONTRACTOR IS TO VERIFY
LOCATION AND GRADE OF ALL EXISTING UTILITIES IN THE VICINITY
PRIOR TO BEGINNING WORK. THE CONTRACTOR SHALL COORDINATE
AND PROVIDE FOR THE PROTECTION OF CONFLICTING UTILITIES. THE
ENGINEER AND/OR OWNER ASSUMES NO RESPONSIBILITY FOR THE
ACCURACY OR COMPLETENESS SHOWN.

BASIS OF BEARINGS:
AN ASSUMED BEARING OF N00°00'00"E FOR THE EAST LINE OF THE
S1/4 SW1/4 OF SECTION 36, MONUMENTED AS SHOWN HEREON.

BASIS OF ELEVATIONS:
A PUBLISHED NAVD88 ELEVATION OF 5354.70 FOR THE C&D
BENCHMARK 828, BEING A BRASS CAP FOUND AT THE SOUTHEAST
CORNER OF COLFAX AVENUE & SHERIDAN STREET, NOT SHOWN.

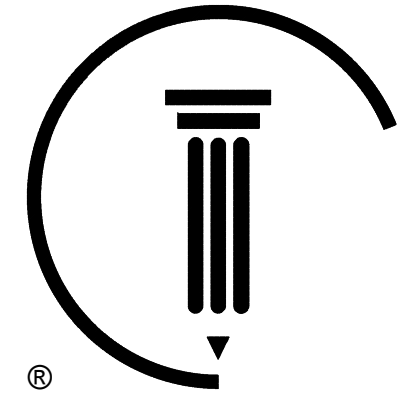

**CUNNINGHAM
GROUP**

Cunningham Group
Architecture, Inc.
601 South Broadway
Suite N
Denver, CO 80209
Tel: 303.861.1600
Fax: 303.861.1602
www.cunningham.com

Consultant
**CREATIVE
CIVIL SOLUTION**
940 Kimbark Street, Suite 2
Longmont, Colorado 80501
303-684-8484

Revisions		
No.	Date	Description
1	7-10-15	Coord Set
	7-17-15	Fire Dept
	8-03-15	Civil 1
	10-29-15	Civil 2
	11-06-15	Civil 3
	01-22-16	PR#06

Document Phase:	Construction Documents
Date:	June 17, 2015
PIC / AIC:	PH
Drawn By:	JRL
Checked By:	CWK
Comm. No.:	CCSF 15003


Project Title
**Great Work Montessori
School**

Sheet Title
**HORIZONTAL
CONTROL
PLAN**

Sheet Number

C150

6015 WEST 16TH AVENUE
LAKEWOOD, COLORADO 80214

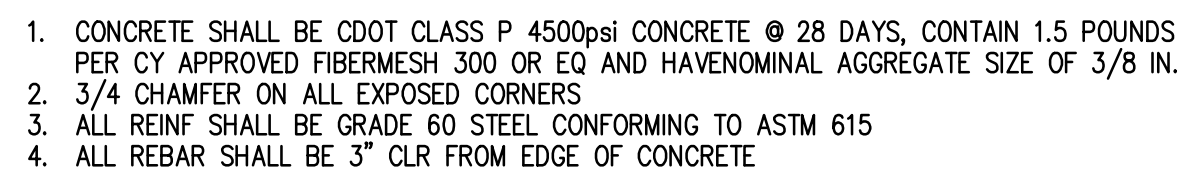

1. DRY WELL SHALL BE 24" DIA HDPE PERFORATED DRYWELL W/ OPEN BOTTOM
2. CONTRACTOR MY SUBSTITUTE 4FT DIAMETER CIRCULAR PERFORATED MANHOLE FOR DRYWELL SHOWN, HOWEVER, DEPTH OF MANHOLE MUST BE 12" DEEPER THAN SHOWN ON PLANS.

1. CONCRETE SHALL BE CDOT CLASS P 4500psi CONCRETE @ 28 DAYS, CONTAIN 1.5 POUNDS PER CY APPROVED FIBERMESH 300 OR EQ AND HAVE NOMINAL AGGREGATE SIZE OF 3/8 IN.
2. 3/4 CHAMFER ON ALL EXPOSED CORNERS
3. TURN DOWN EDGE SHALL OCCUR WHEN DRAINAGE PAN IS IMMEDIATELY ADJACENT TO THE EWF PLAYGROUND.


1. CONCRETE SHALL BE CDOT CLASS P 4500psi CONCRETE @ 28 DAYS, CONTAIN 1.5 POUNDS PER CY APPROVED FIBERMESH 300 OR EQ AND HAVE NOMINAL AGGREGATE SIZE OF 3/8 IN.
2. 3/4 CHAMFER ON ALL EXPOSED CORNERS
3. ALL REINF SHALL BE GRADE 60 STEEL CONFORMING TO ASTM 615
4. ALL REBAR SHALL BE 3" CLR FROM EDGE OF CONCRETE

CONCRETE SHALL BE 6 SACK MINIMUM CLASS "P" 4500 PSI @ 28 DAYS
CONCRETE SHALL BE REINFORCED W/ FIBER MESH.
ACO DRAIN CONCRETE TO BE SEPARATED FROM STRUCTURAL SLAB
W EXPANSION JOINT AT EDGE
GRATE TO BE LONGITUDINAL GRAY PLASTIC ADA GRATING TYPE 495Q

*DESIGN BUILD INSTALLATION FENCE TO BE BUILT PER LOCAL CODES W/ CLAMPS PLACED TO PROVIDE TIGHT, NON-SAGGING FENCING & RIGID POST SEETINGS IN GRD.

1. 8" PVC TO BE SDR 35 PVC
2. NO MORE THAN 3~45° BENDS MAY BE USED FOR ROOF DRAIN CONNECTIONS

GREAT WORK MONTESSORI SITE PLAN AT 6015 W. 16TH AVE. LAKEWOOD, COLORADO 80215 / CASE # ZP-15-013

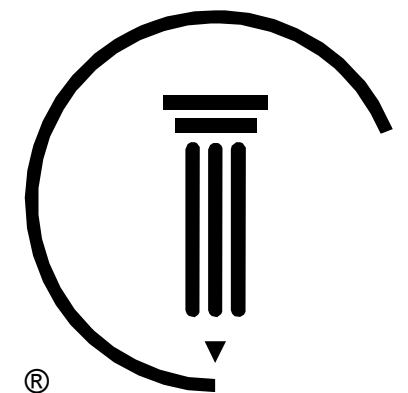

CUNNINGHAM
GROUP

Cunningham Group
Architecture, Inc.
601 South Broadway
Suite N
Denver, CO 80209
Tel: 303 861 1600
Fax: 303 861 1602
www.cunningham.com

Consultant

Revisions		
No.	Date	Description
1	10/14/15	Addedendum #01
3	12/18/15	PR#04
4	01/07/16	ASH#01
6	01/18/16	PR#07
7	01/20/16	PR#06
8	01/22/16	PR#08

Document Phase: Construction Documents
Date: July 17, 2015
PIC / AIC: PH
Drawn By: Author
Checked By: Checker
Comm. No.: PR14-0744

Project Title
Great Work Montessori School

Sheet Title
Floor Plan

Sheet Number


A100

Copyright © 2014 by Cunningham Group Architecture, Inc. (All Rights Reserved)

Keynote Legend	
Key Value	Keynote Text
A1	New aluminum storefront door
A2	New aluminum storefront window throughout except North Wing - North Elevation
A3	24" deep counter with base cabinets. T.O. counter 34" A.F.F.
A4	24" deep counter with base cabinets. T.O. counter 22.5" A.F.F.
A5	New interior ramp with handrails both sides
A9	Existing upper and base cabinets to remain
A10	Undercounter refrigerator
A12	Custom wood cubbies similar to residential cabinets
A16	Washer and Dryer
A18	Floor sink
A19	Partial height partition
A21	Observation window
A24	Existing downsputs
A30	4'X 8' Chalkboard
A31	3' X 8' Tackboard
A33	Existing CMU wall to remain
A34	Full size refrigerator
A35	New wood post, TYP
A37	Chase
A38	Copier by Owner
A39	Floor Access Panel
A40	Refer to Sheet A102 for clerestory windows at South elevations of North and South wings
A41	Vent Hinged Louver. Refer to Building Elevations Sheet A300 for location
A42	Surface Mounted Knox Box
A45	New butcher block where cook top was removed. Cut in flushed with counter
A46	Open shelves where double oven was removed. Wood to match existing cabinets
A48	Fire extinguisher cabinet
A49	Privacy film glazing

GENERAL NOTES

- 1- PROVIDE CORNER GUARDS AT ALL EXTERNAL CORNERS
- 2- TOILET ACCESSORIES (EXCEPT MIRRORS AND GRAB BARS) TO BE PROVIDED BY OWNER, INSTALLED BY GENERAL CONTRACTOR.
- 3- PROVIDE BLOCKING AT WALLS WHERE TOILET ACCESSORIES ARE SHOWN.

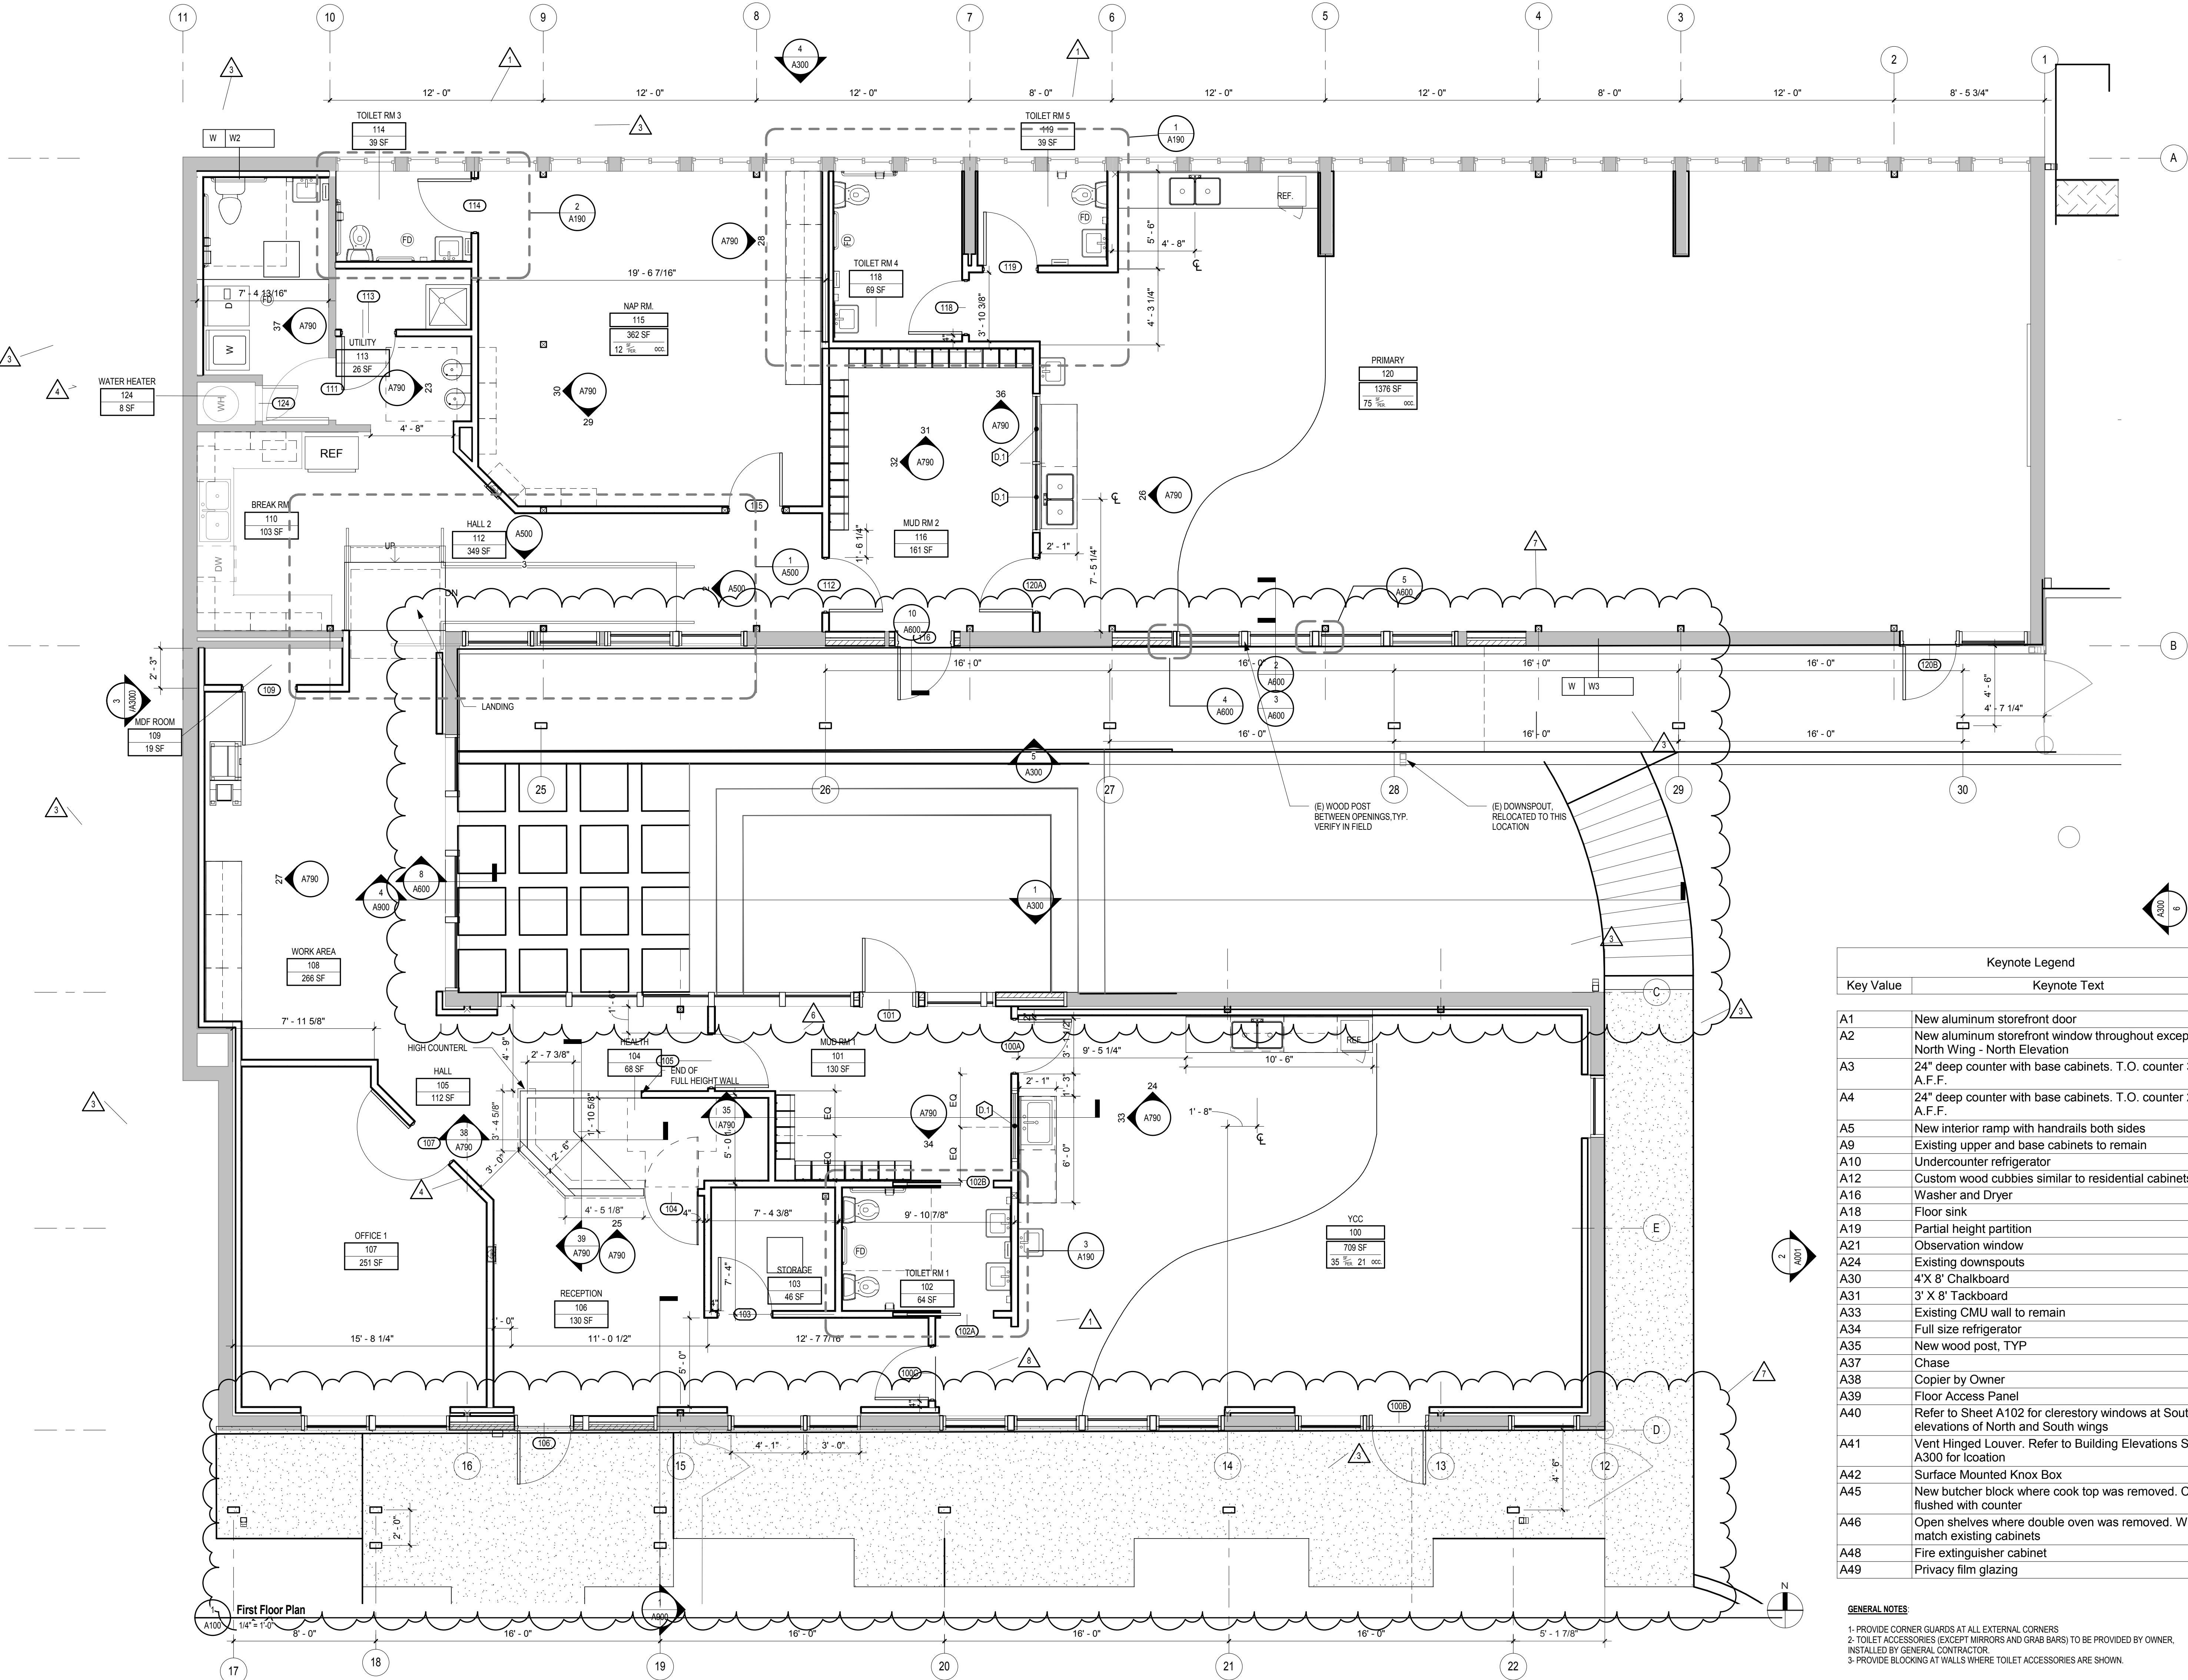



www.cunningham.com

Consultant

No.	Date	Description
7	01/20/16	PR#06

Document Phase:	Construction Document
Date:	July 17, 2014
Project A/C:	PR14-074
Drawn By:	Auth
Checked By:	Check
Comm. No.:	PR14-074

Project Title

Great Work Montessori School

Keynote Legend	
Key Value	Keynote Text
A22	Existing photovoltaic panels to remain
A23	Sloped asphalt shingles roof
A24	Existing downspouts
A25	Existing gutter
A26	Existing rooftop unit curb to remain. Patch opening
A27	Flat roof area
A28	Parapet wall
A44	Roof penetrations. Refer to Plumbing and Mechanical drawings for locations
A50	6" min. batt insulation and vapor barrier at Attic


Sheet Title

Roof Plan

Sheet Number

A200

© 2014 by Cunningham Group Architecture, Inc. (All Rights Reserved)

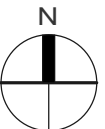

C:\Rev\local\14-0744_GreenWork\Montessori-Central_mSabbas.rvt

1/22/2016 2:32:52 PM



www.cunningham.com

Consultant

No.	Date	Description
5	01/15/16	PR#05
7	01/20/16	PR#06

Document Phase:	Construction Document
Date:	July 17, 2014
Project A/C:	PR14-074
Drawn By:	Auth
Checked By:	Check
Comm. No.:	PR14-074

Project Title

Great Work Montessori School

Sheet Title



New Building Elevation

Sheet Number


A300

© 2014 by Cunningham Group Architecture, Inc. (All Rights Reserved)


- 1- EXTERIOR PAINT COLORS TO BE DETERMINED
- 2- TRIM AT FASCIA TO BE PAINTED
- 3- TRIM ABOVE AND BELOW WINDOWS TO BE PAINTED
- 4- 2X MEMBERS AT COVERED AREA TO BE PAINTED
- 5- GUTTERS AND DOWNSPOUTS TO BE PAINTED

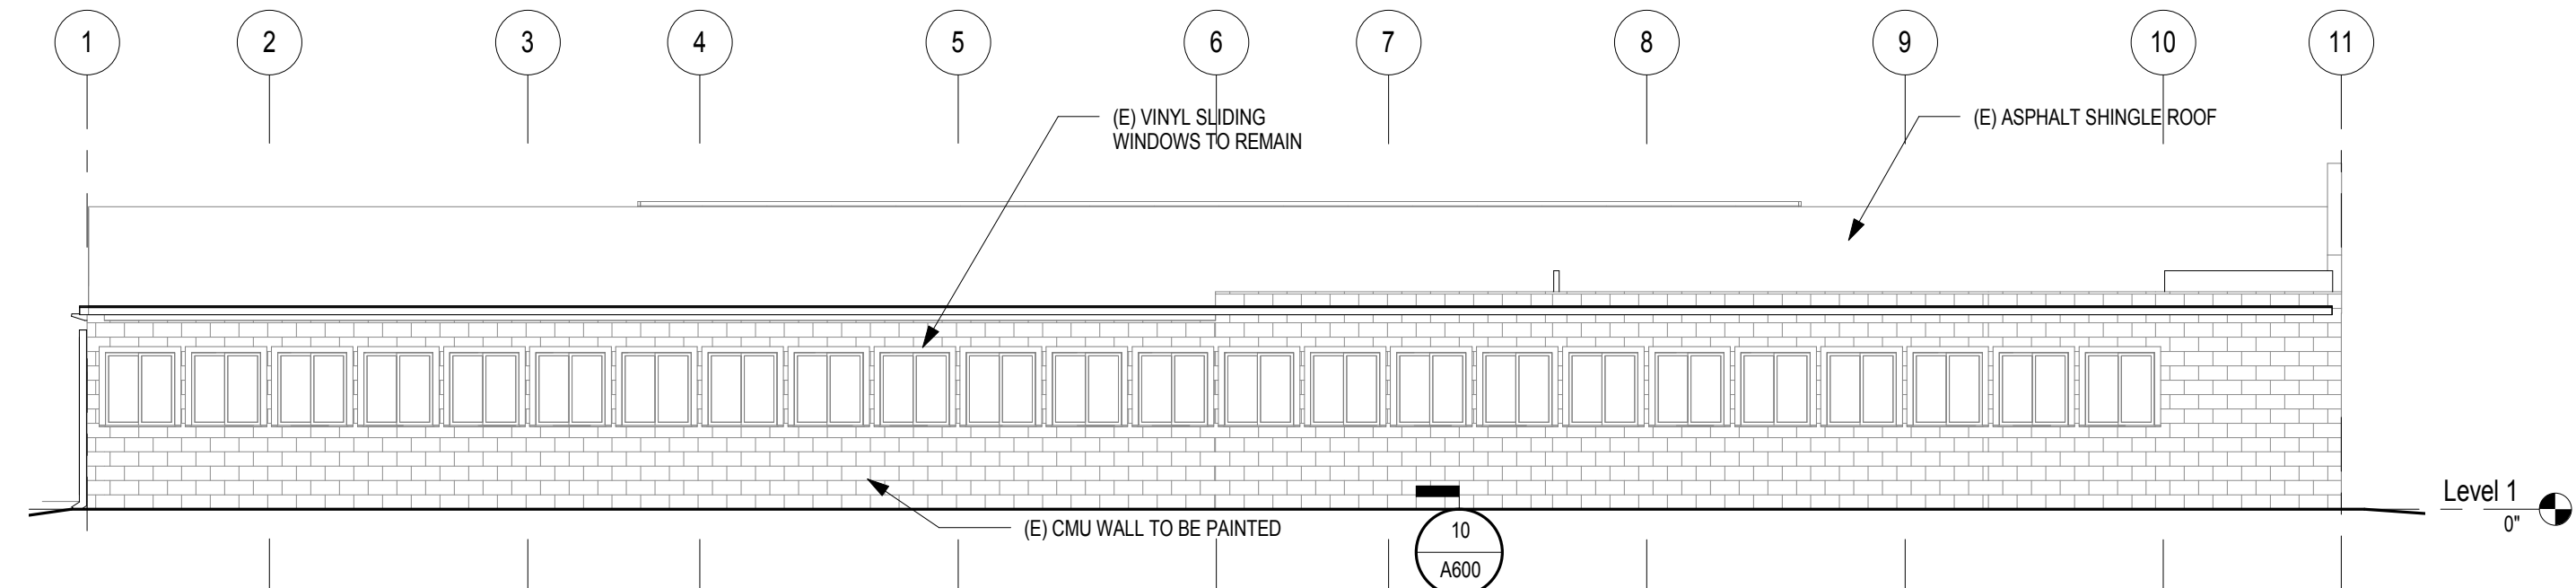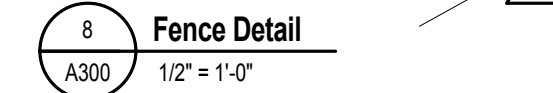


1 South Wing - North Elevation
A300 1/8" = 1'-0"

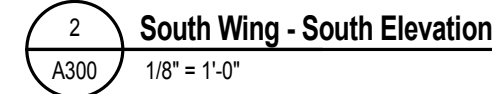

4 North Wing - North Elevation
A300 1/8" = 1'-0"

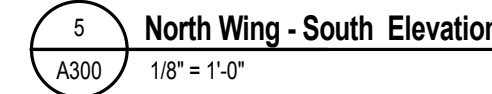

3 West Elevation
A300 $1/8" = 1'-0"$

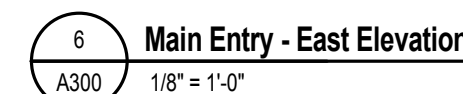



www.cunningham.com

Consultant

Divisions		
No.	Date	Description
7	01/20/16	PR#06
8	01/22/16	PR#08


What Work Montessori School

Reflected Ceiling Plan

Sheet Number


A810

© 2014 by Cunningham Group Architecture, Inc. (All Rights Reserved)

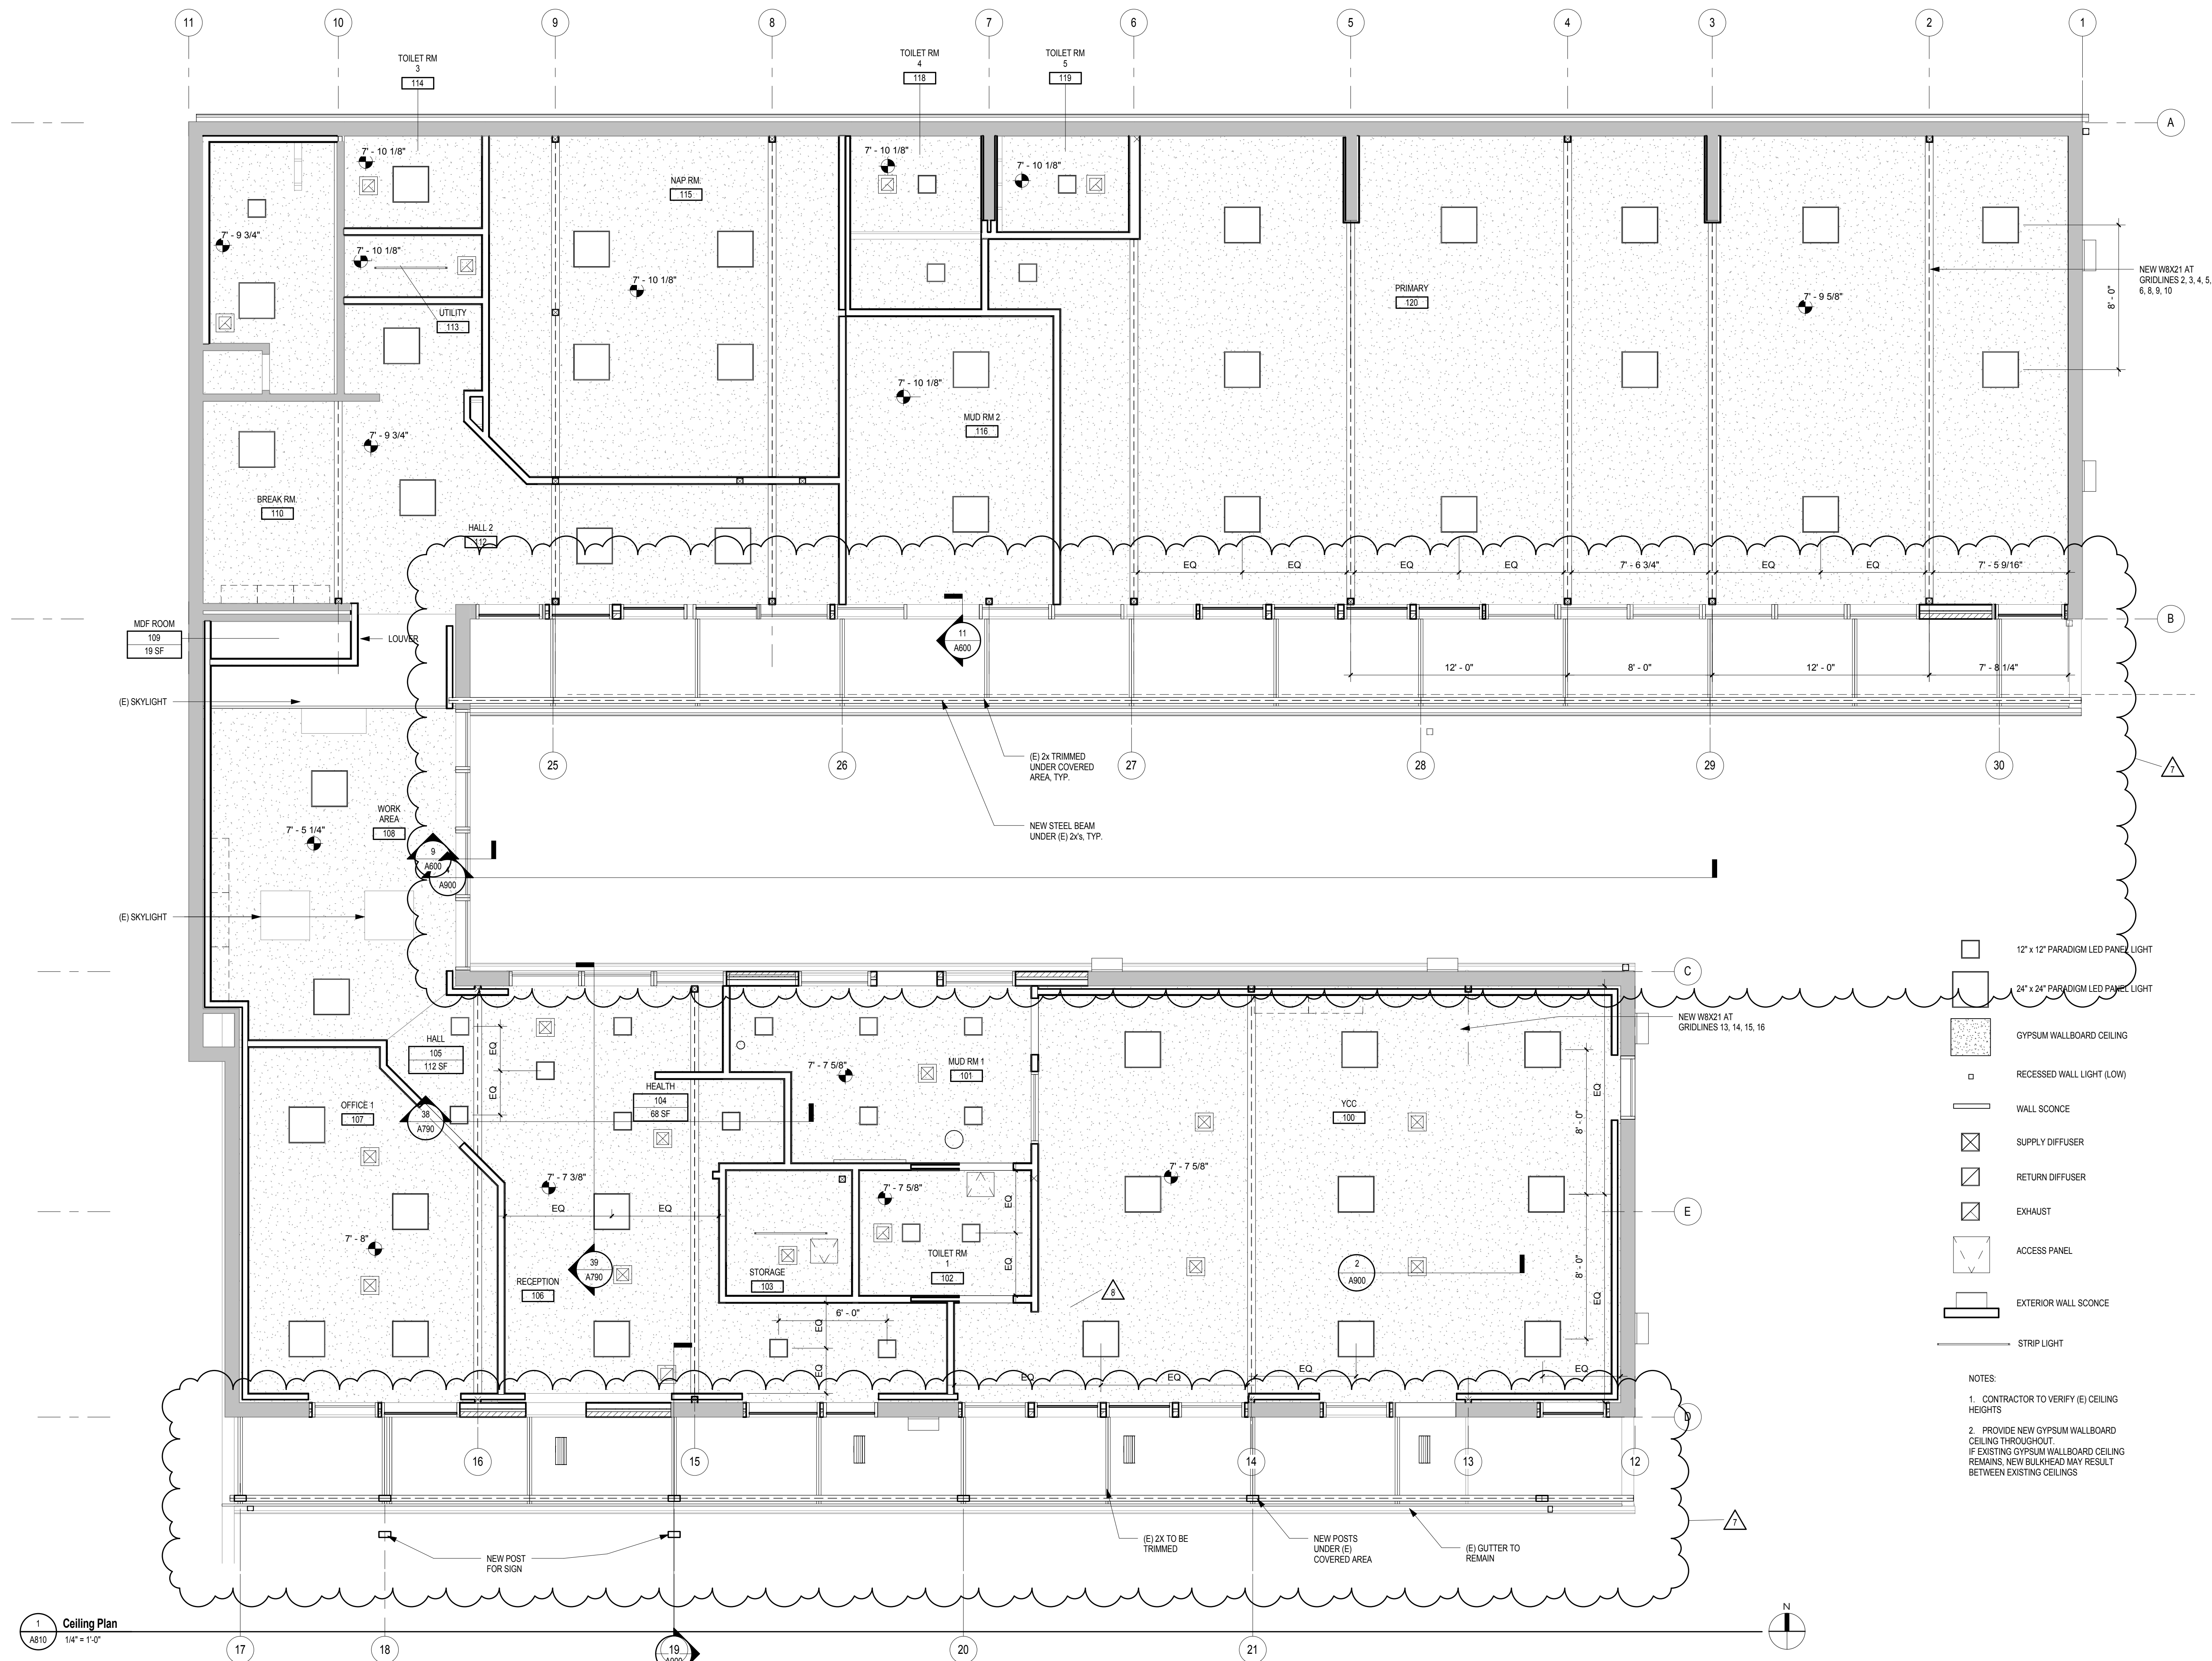

1 Ceiling Plan
A810 1/4" = 1'-0"

Ceiling F
1/4" = 1'-0"

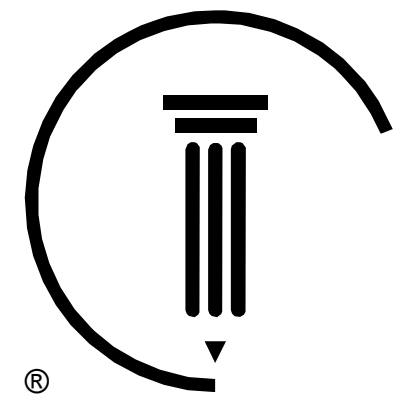

CUNNINGHAM
G R O U P

Cunningham Group
Architecture, Inc.
801 South Broadway
Suite N
Denver, CO 80209
Tel: 303 861 1600
Fax: 303 861 1602
www.cunningham.com

Consultant

Revisions		
No.	Date	Description
7	01/20/16	PR#06

Document Phase:	Construction Documents
Date:	July 17, 2015
PIC / AIC:	PH
Drawn By:	Author
Checked By:	Checker
Comm. No.:	PR14-0744


Project Title
**Great Work Montessori
School**

Sheet Title
Miscellaneous Details


Sheet Number

A900


Copyright © 2014 by Cunningham Group Architecture, Inc. (All Rights Reserved)

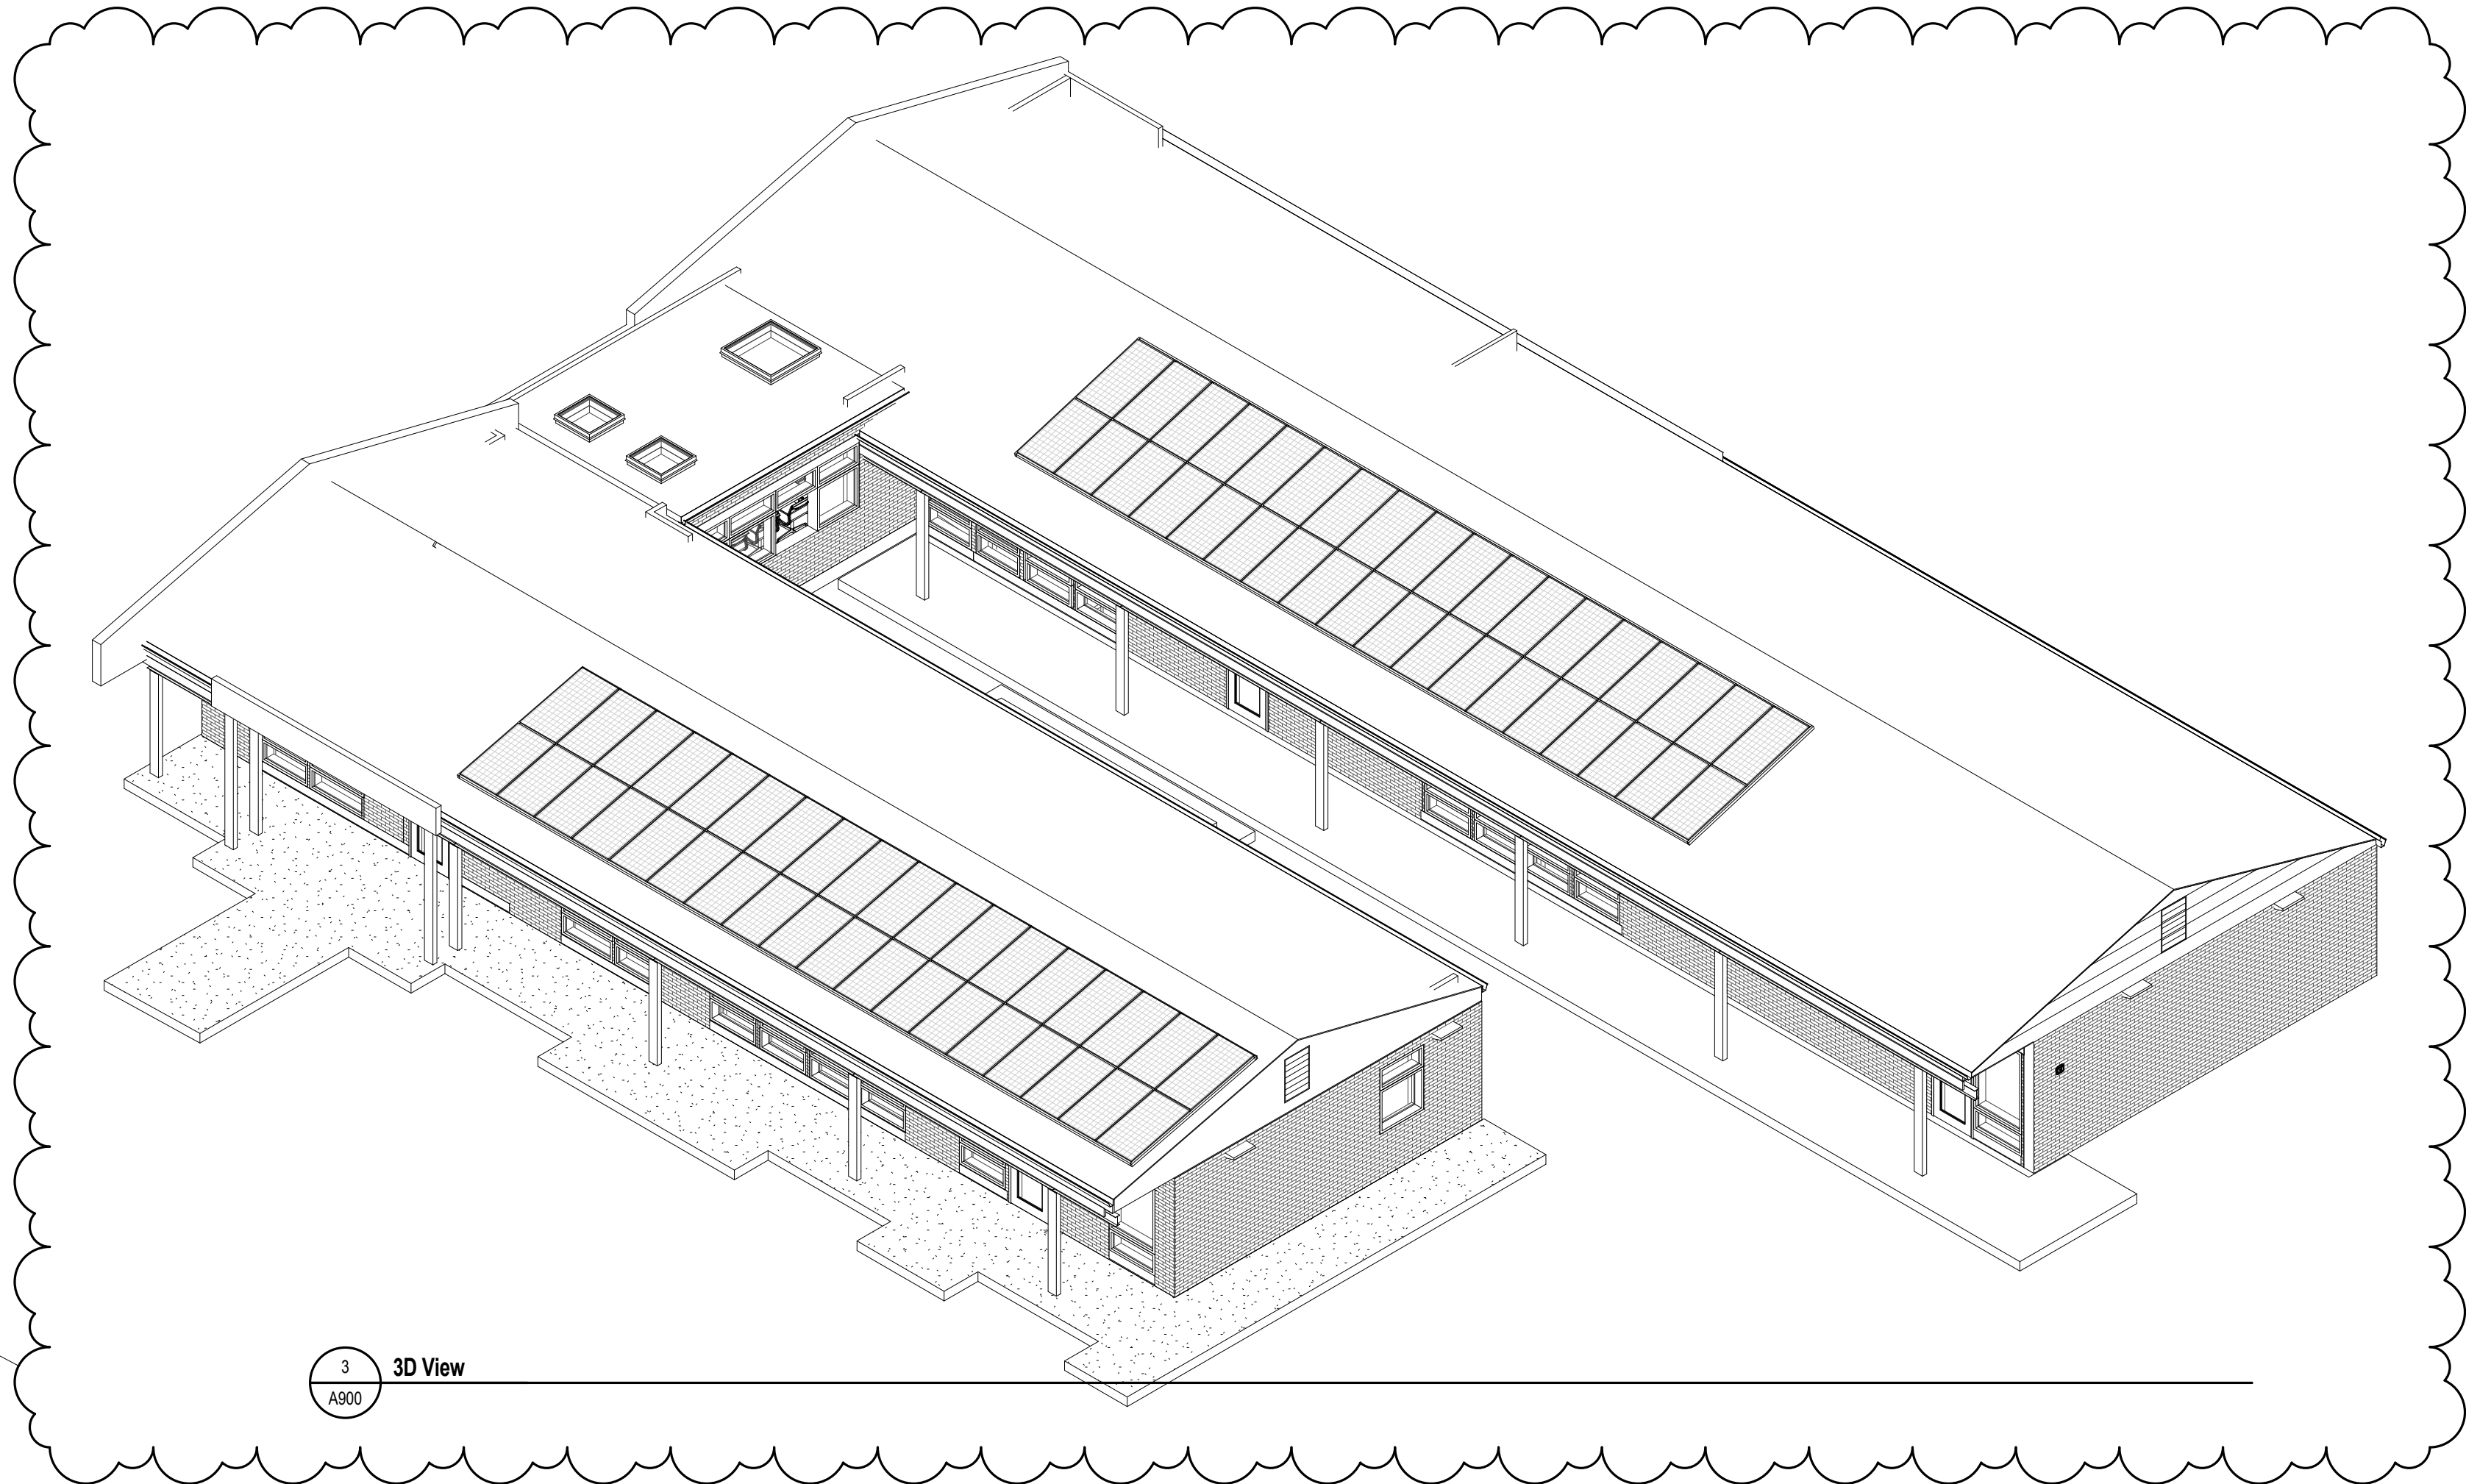


3
A900
3D View

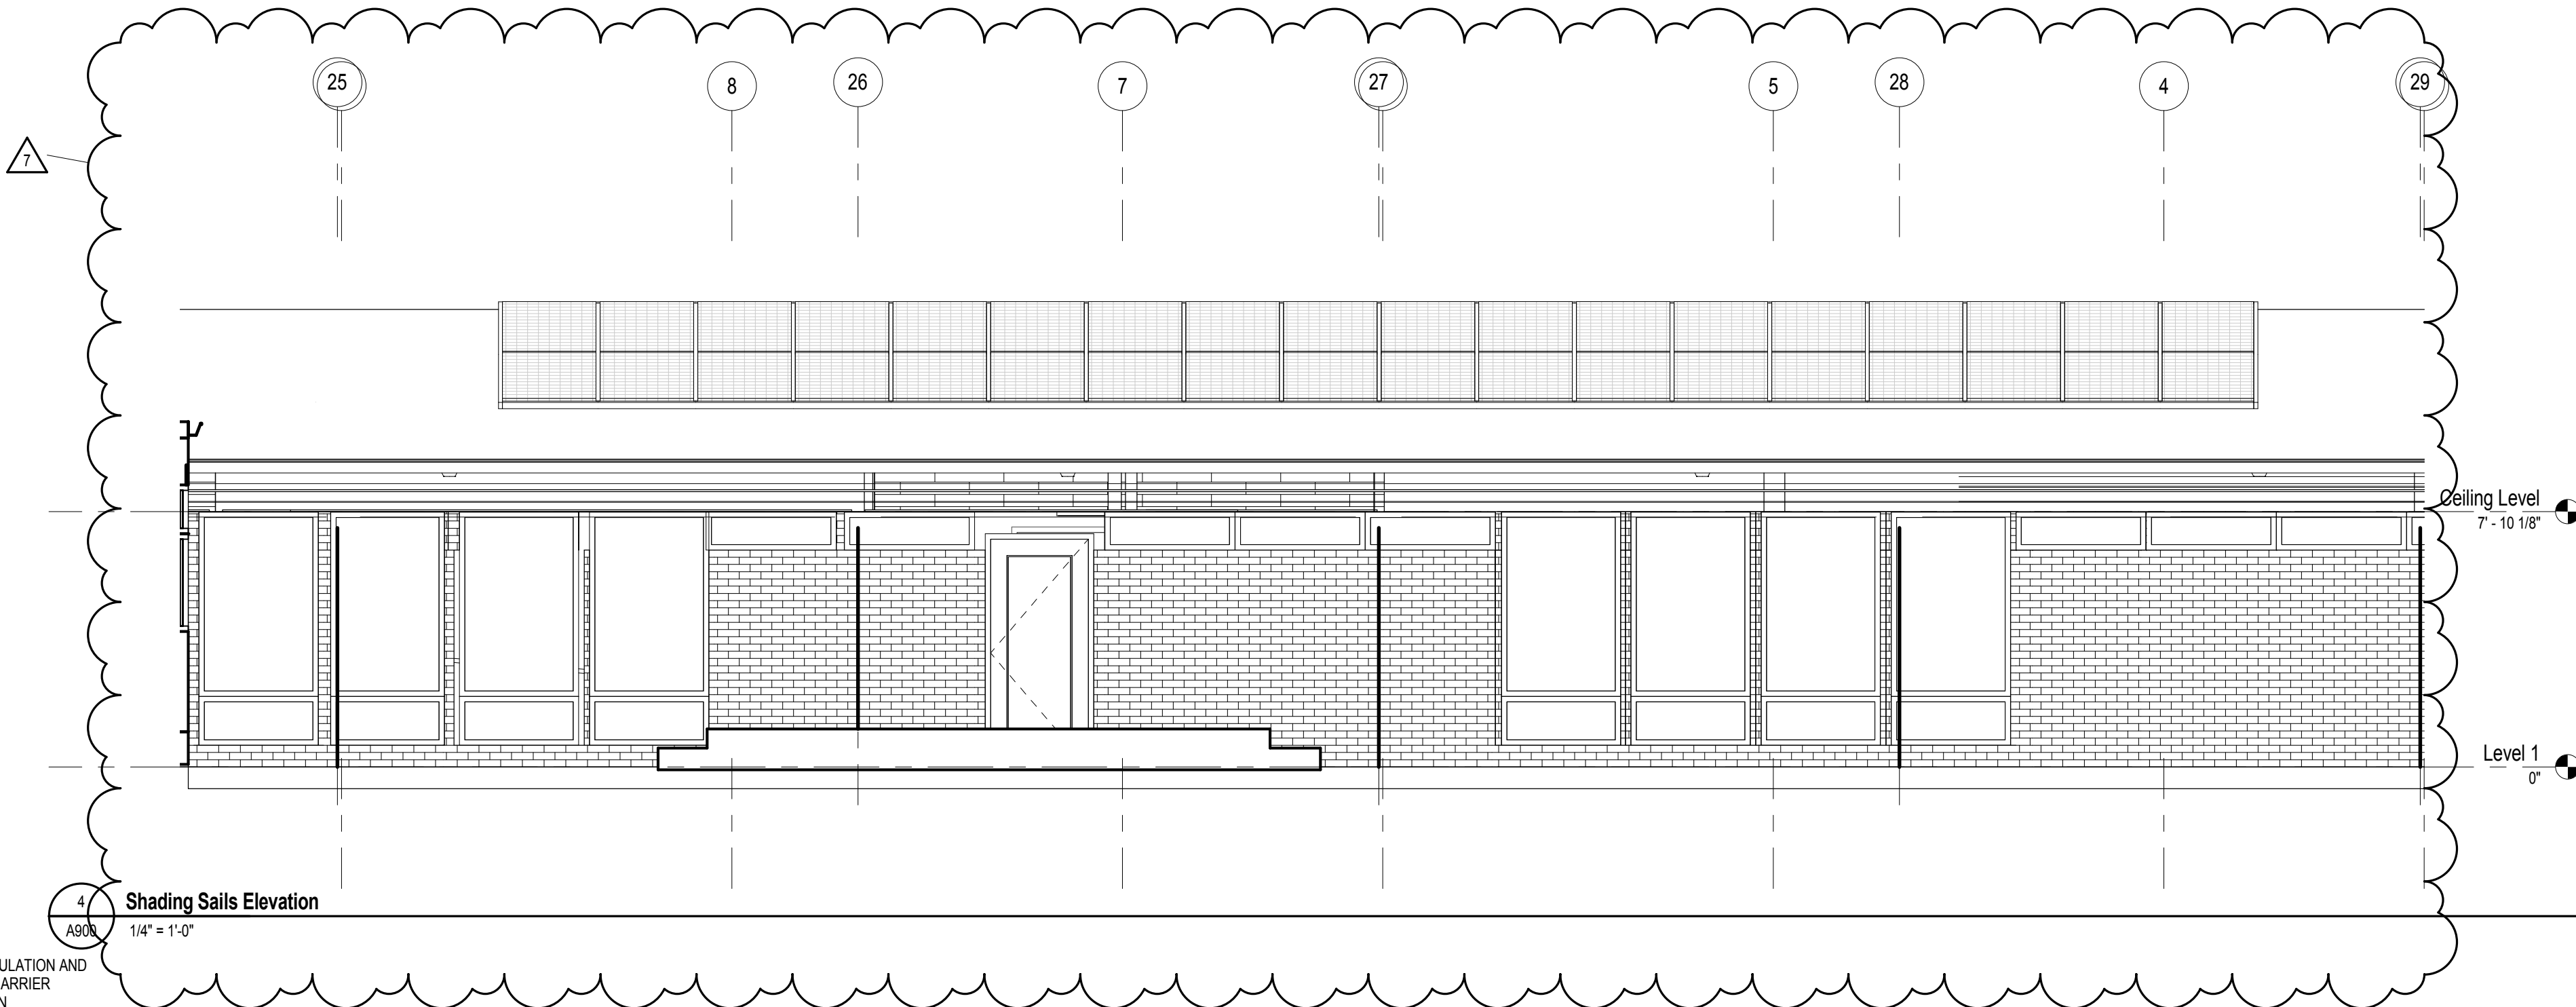


4
A900
Shading Sails Elevation
1/4" = 1'-0"

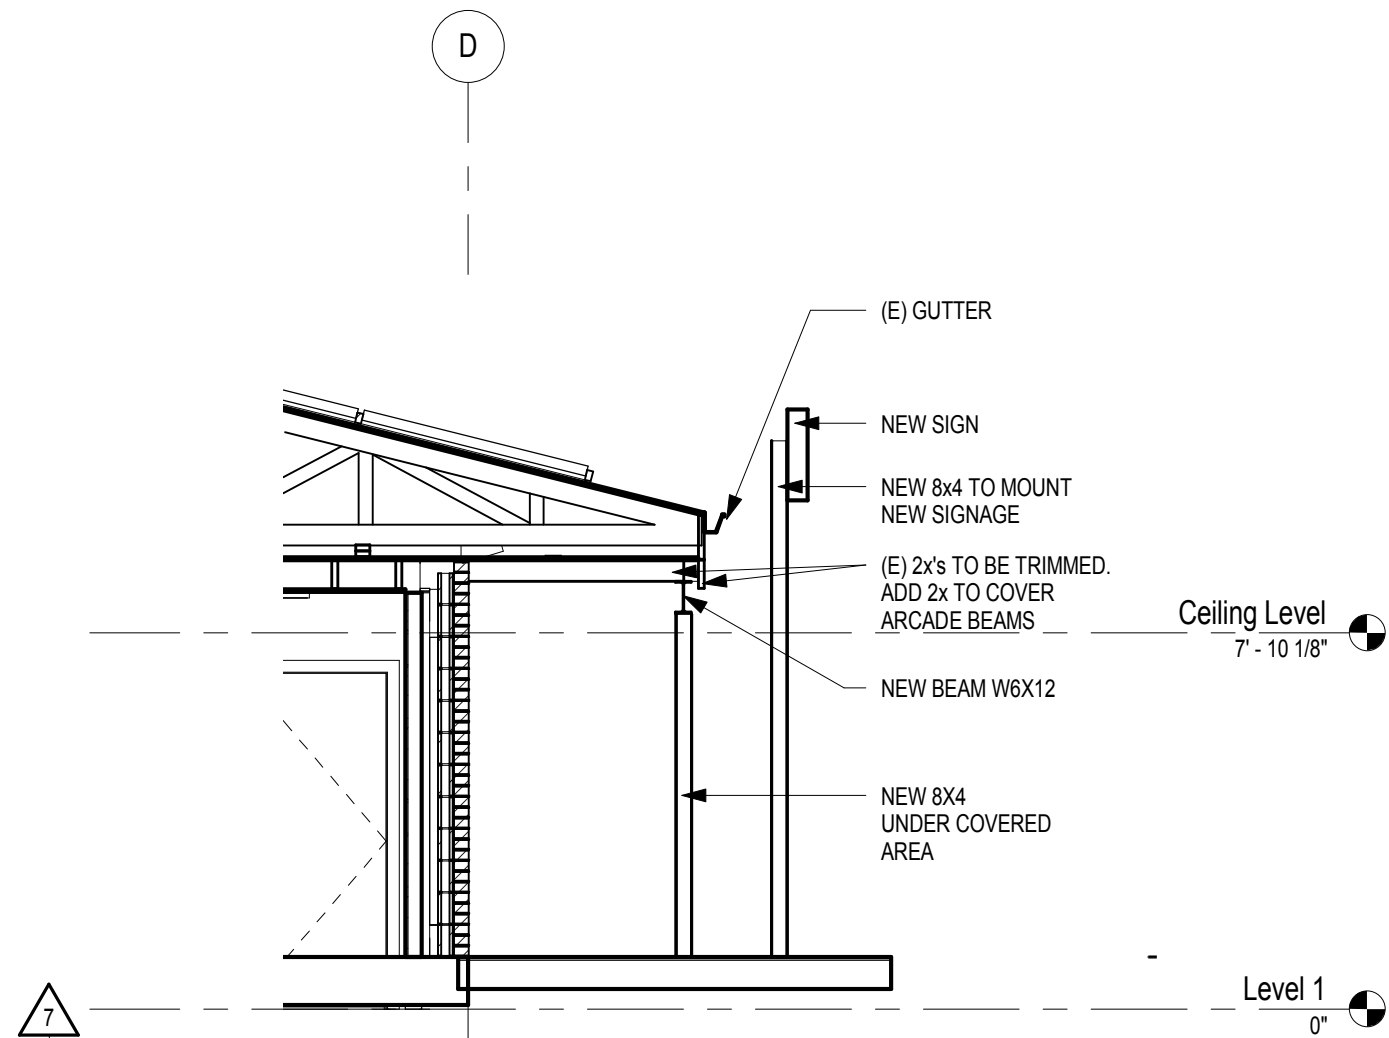

1
A900
Section 3
1/4" = 1'-0"

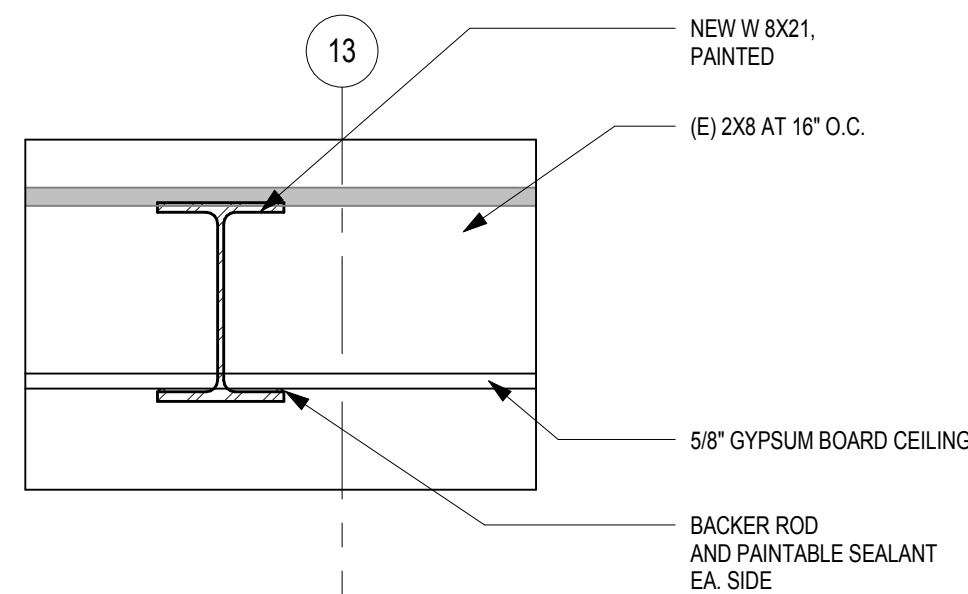

2
A900
Ceiling Detail 2
1 1/2" = 1'-0"

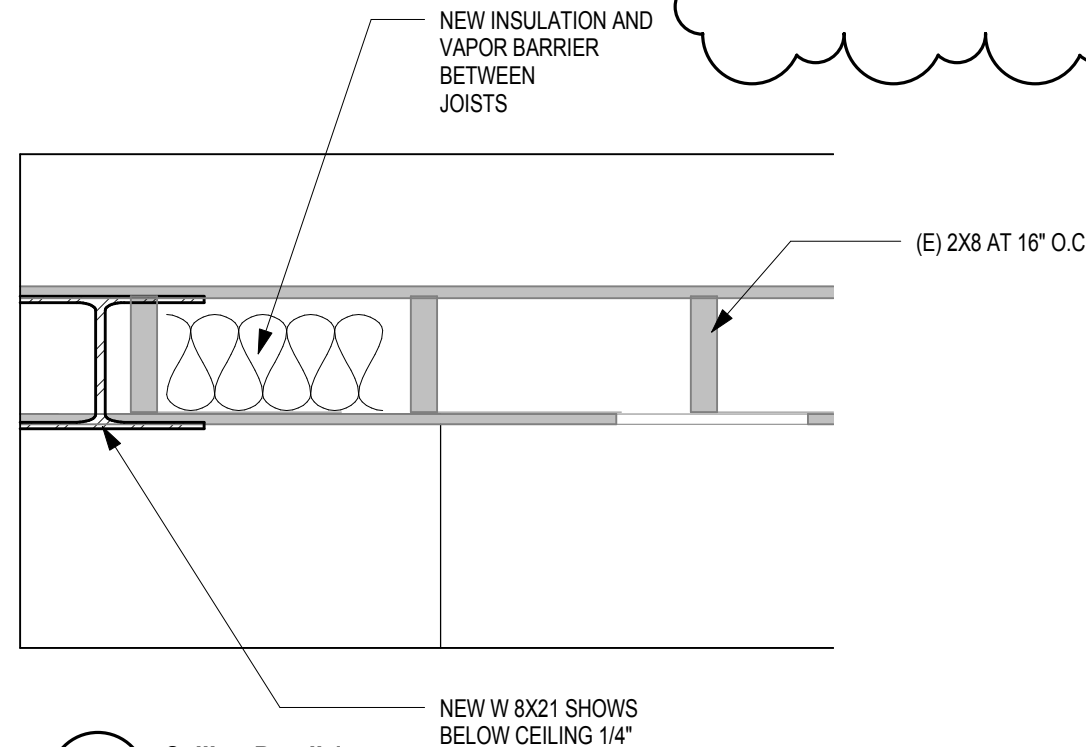

5
A900
Ceiling Detail 1
1" = 1'-0"



www.cunningham.com

Consulting Structural Engineers
517th Street, Denver, Colorado 80211
303-783-4797 Fax 303-830-9133
www.anchoreng.com


Date	Description
01/20/16	PR#06

Great Work Montessori School

A circular professional engineer seal for David A. Poe. The outer ring contains the text "COLORADO LICENSED" at the top and "PROFESSIONAL ENGINEER" at the bottom, separated by dots. The inner circle contains the name "DAVID A. POE" at the top and the license number "33278" in the center.

S100

© 2014 by Cuninghame Group Architecture, Inc. All Rights Reserved

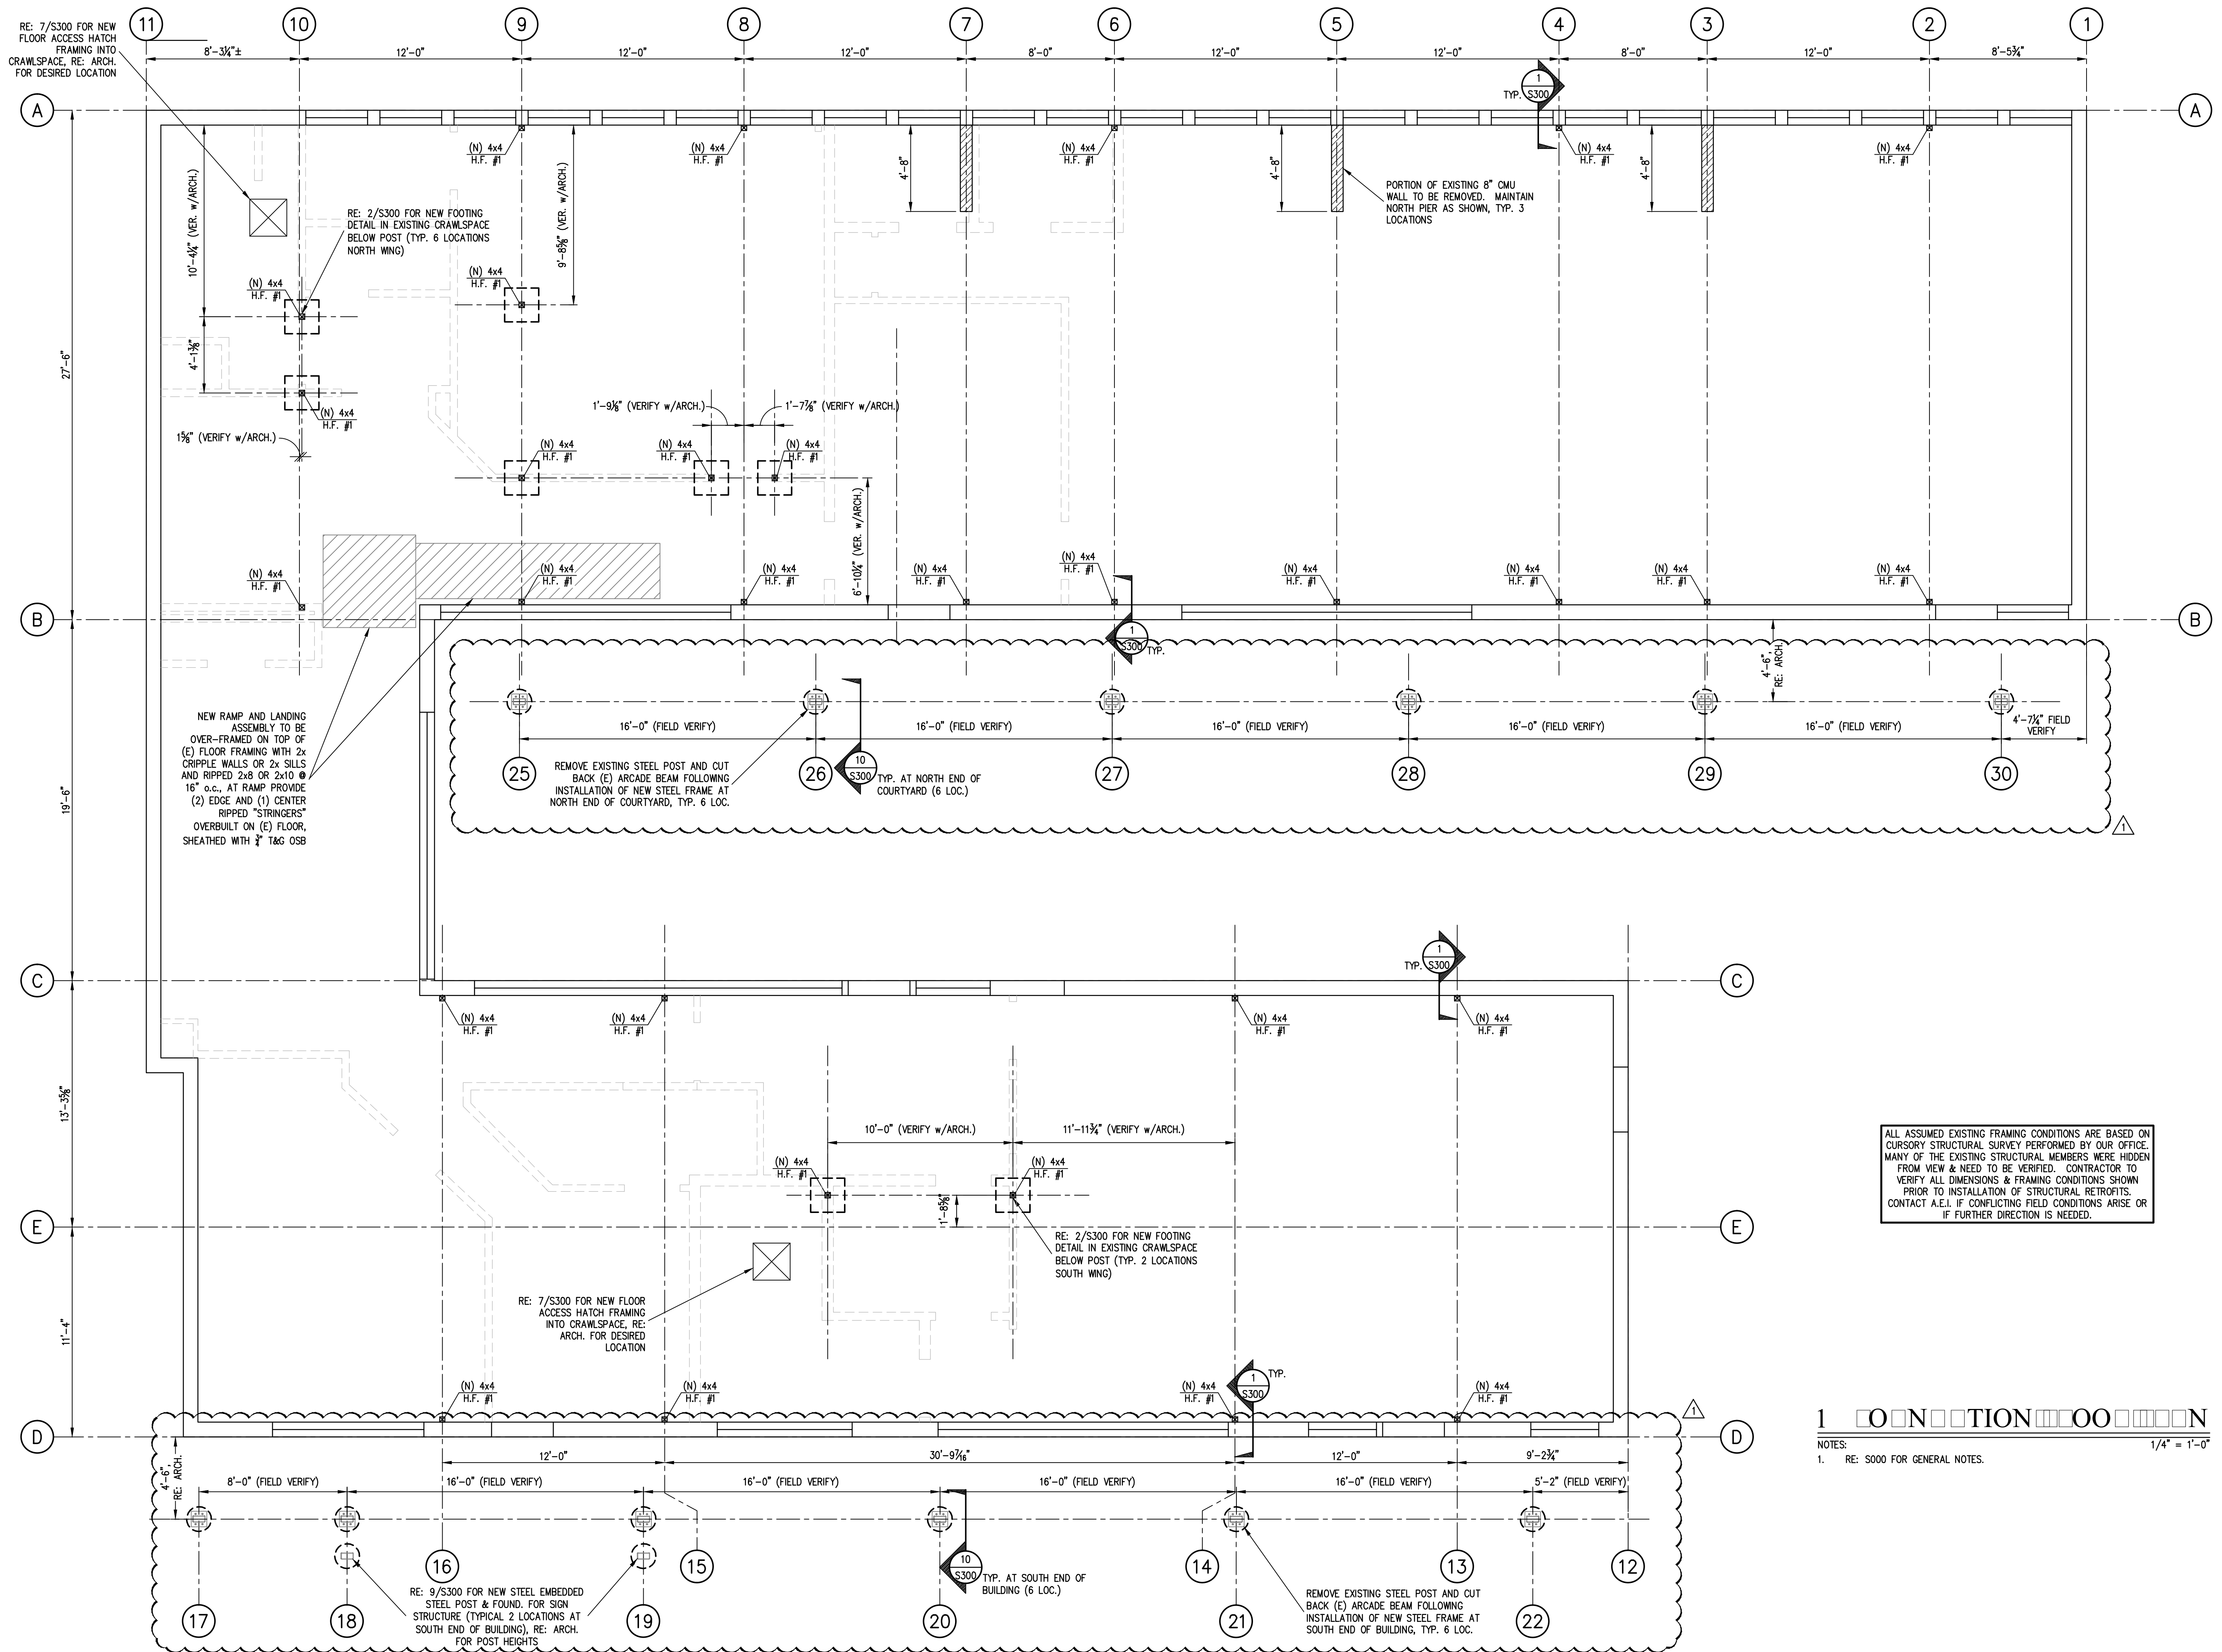

ALL ASSUMED EXISTING FRAMING CONDITIONS ARE BASED ON
CURSORY STRUCTURAL SURVEY PERFORMED BY OUR OFFICE.
MANY OF THE EXISTING STRUCTURAL MEMBERS WERE HIDDEN
FROM VIEW & NEED TO BE VERIFIED. CONTRACTOR TO
VERIFY ALL DIMENSIONS & FRAMING CONDITIONS SHOWN.
PRIOR TO INSTALLATION OF STRUCTURAL RETROFITS.
CONTACT A.E.I. IF CONFLICTING FIELD CONDITIONS ARISE OR
IF FURTHER DIRECTION IS NEEDED.

CONSTRUCTION

NOTES:



1. RE: S000 FOR GENERAL NOTES.

$$/4^n = 1'-0^n$$

© 2014 by Cuninghame Group Architecture, Inc. (All Rights Reserved)

C:\Shared\Local4\4-0744_GreatWorkMontessori\Central_danaric.rvt

7/15/2019 9:31:59 AM

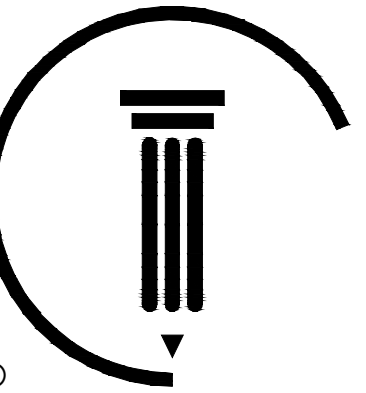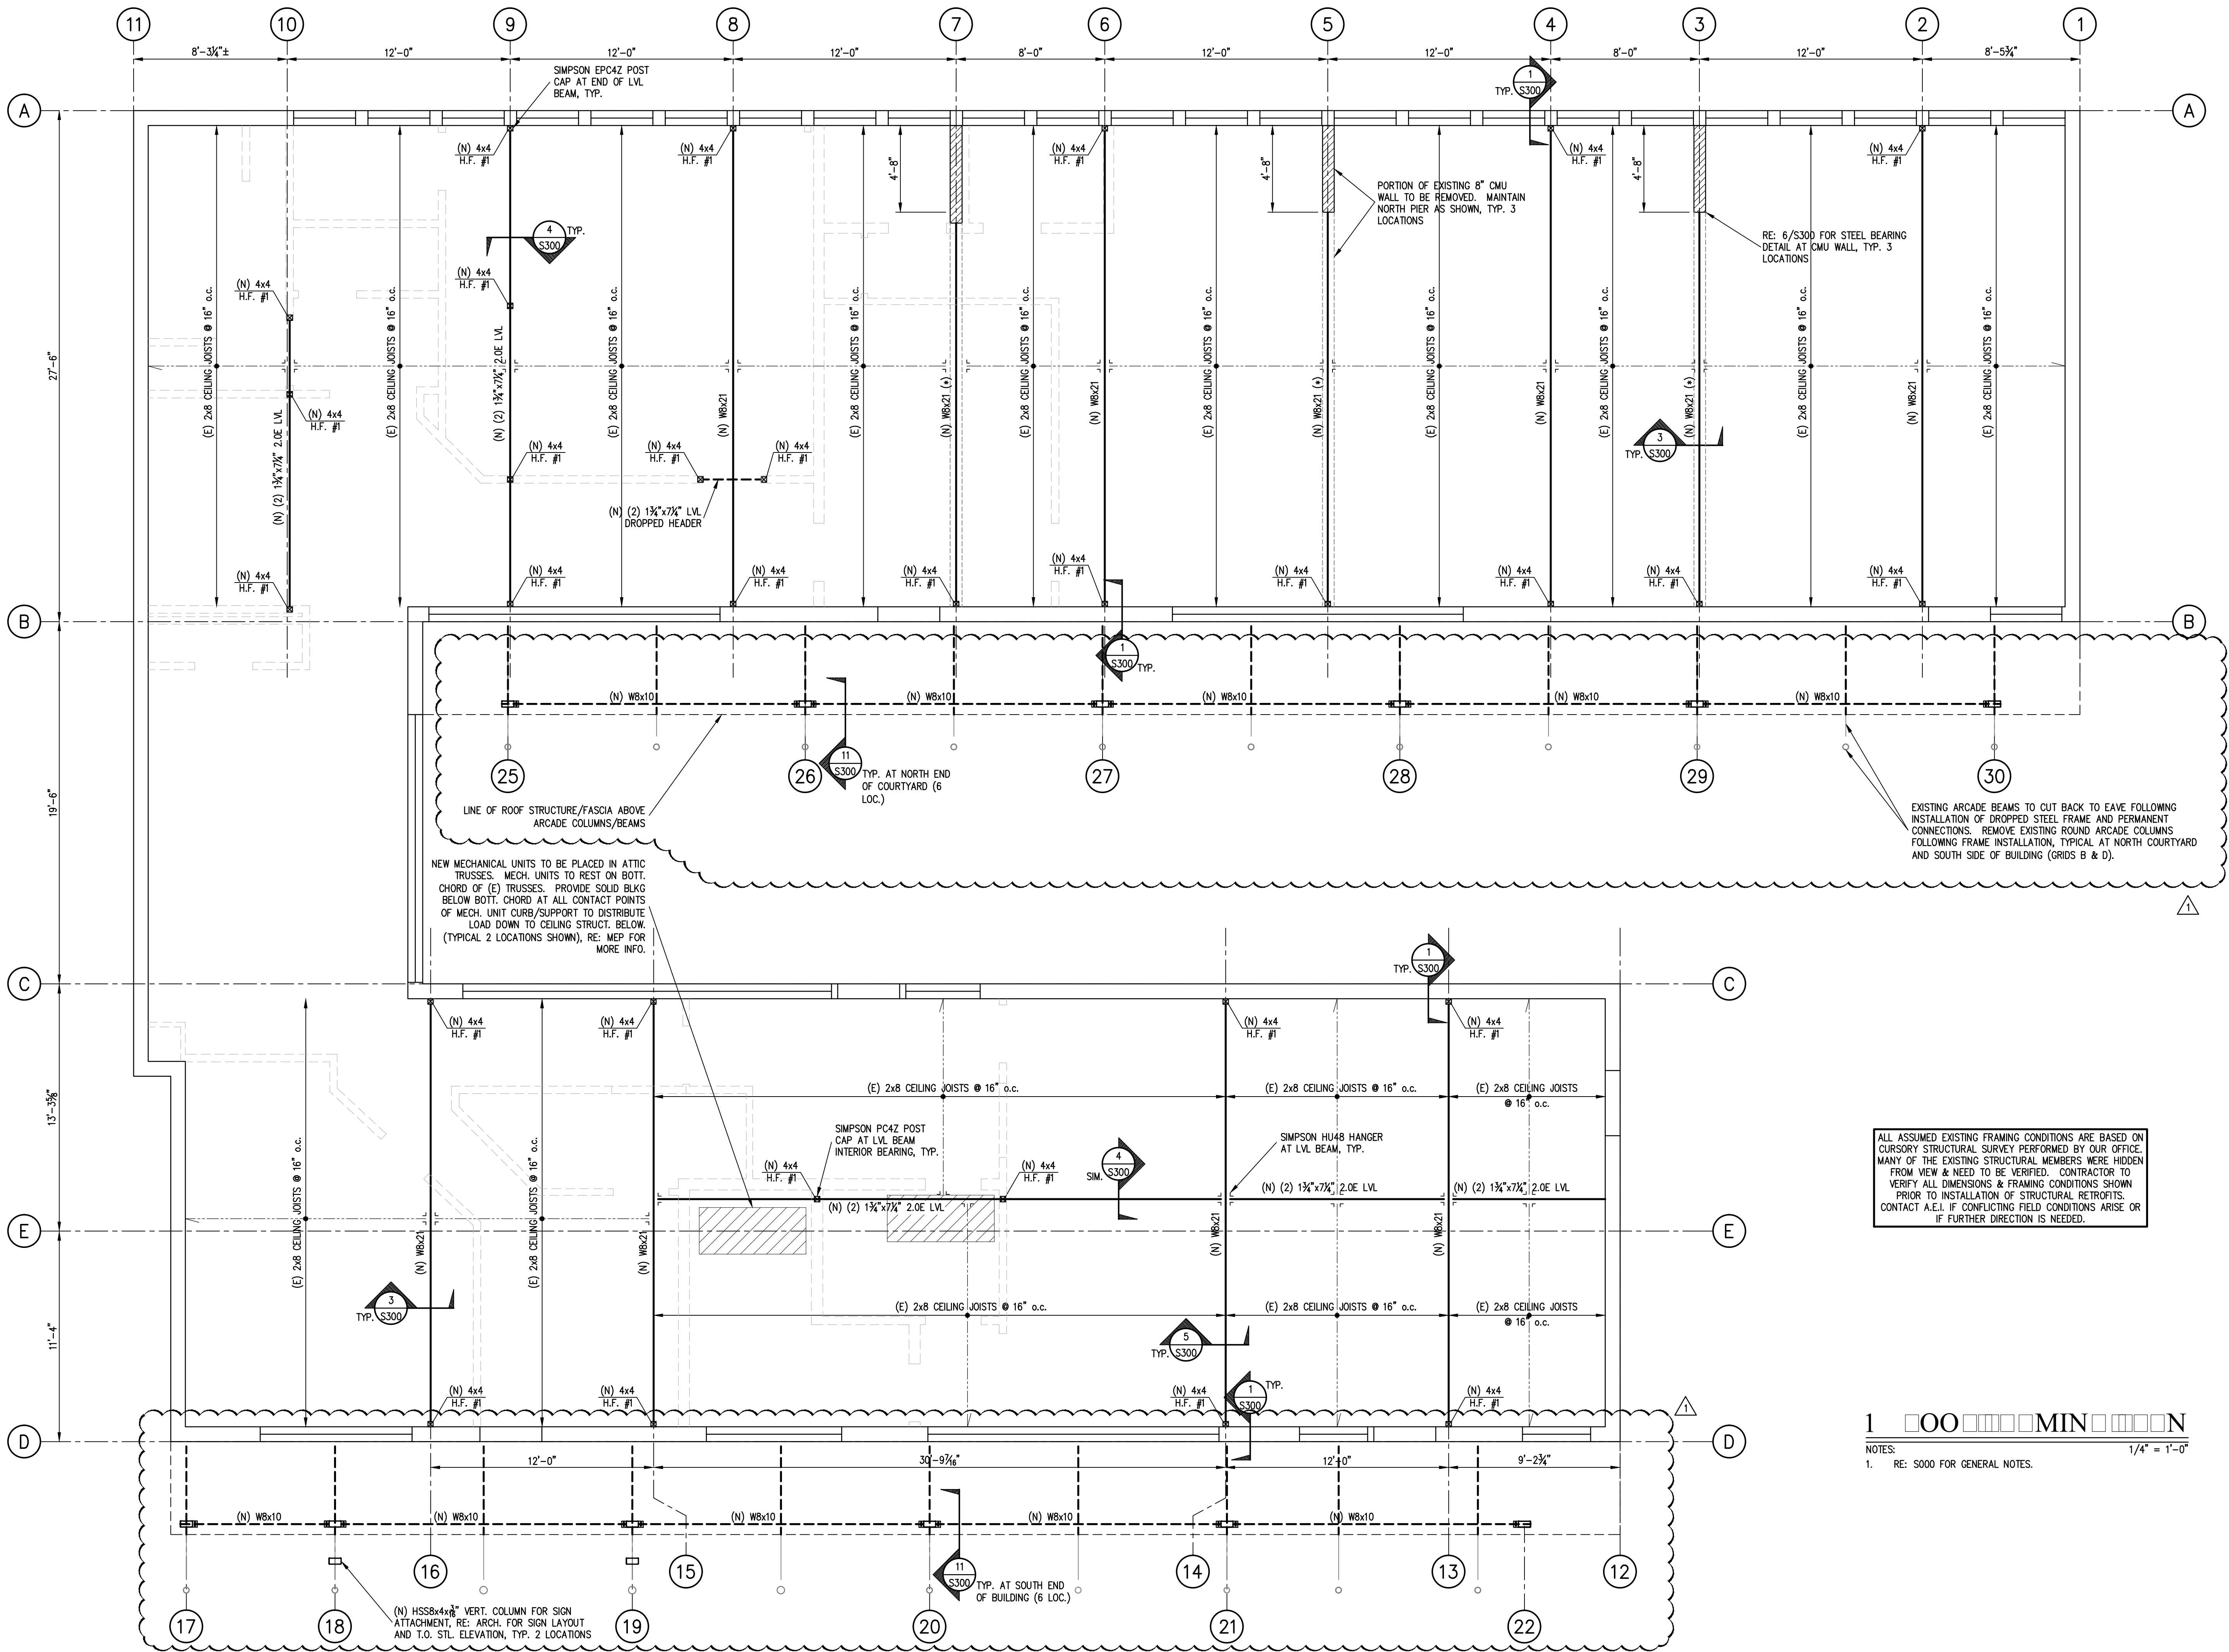

**CUNNINGHAM
GROUP**

Cunningham Group
Architecture, Inc.
601 South Broadway
Suite N
Denver, CO 80209
Tel: 303 861 1600
Fax: 303 861 1602
www.cunningham.com

Consultant

ANCHOR ENGINEERING, INC.
Consulting Structural Engineers
2535 17th Street, Denver, Colorado 80211
303-733-4197 Fax 303-733-9333
www.anchoreng.com

Revisions		
No.	Date	Description
1	01/20/16	PR#06

Document Phase: Construction Documents
Date: July 17, 2015
PIC / AIC: PH
Drawn By: DD
Checked By: AIS
Comm. No.: PR14-0744

Project Title
**Great Work Montessori
School**

Sheet Title
Roof Framing Plan



Sheet Number

S200

Copyright © 2014 by Cunningham Group Architects, Inc. (All Rights Reserved)



CUNNINGHAM
GROUP

Cunningham Group
Architecture, Inc.

601 South Broadway
Suite N
Denver, CO 80209

Tel: 303 861 1600
Fax: 303 861 1602

www.cunningham.com

Consultant

ANCHOR ENGINEERING, INC.

Consulting Structural Engineers

2335 17th Street, Denver, Colorado 80211
303-733-0197 Fax 303-733-0133
www.anchoreng.com

Revisions

No.	Date	Description
1	01/20/16	PR#06

Document Phase: Construction Documents

Date: July 17, 2015

PIC / AIC: PH

Drawn By: DD

Checked By: AJIS

Comm. No.: PR14-0744

Project Title

Great Work Montessori
School

Sheet Title


Found. & Framing
Details




Sheet Number

S300


Copyright © 2014 by Cunningham Group Architecture, Inc. (All Rights Reserved)

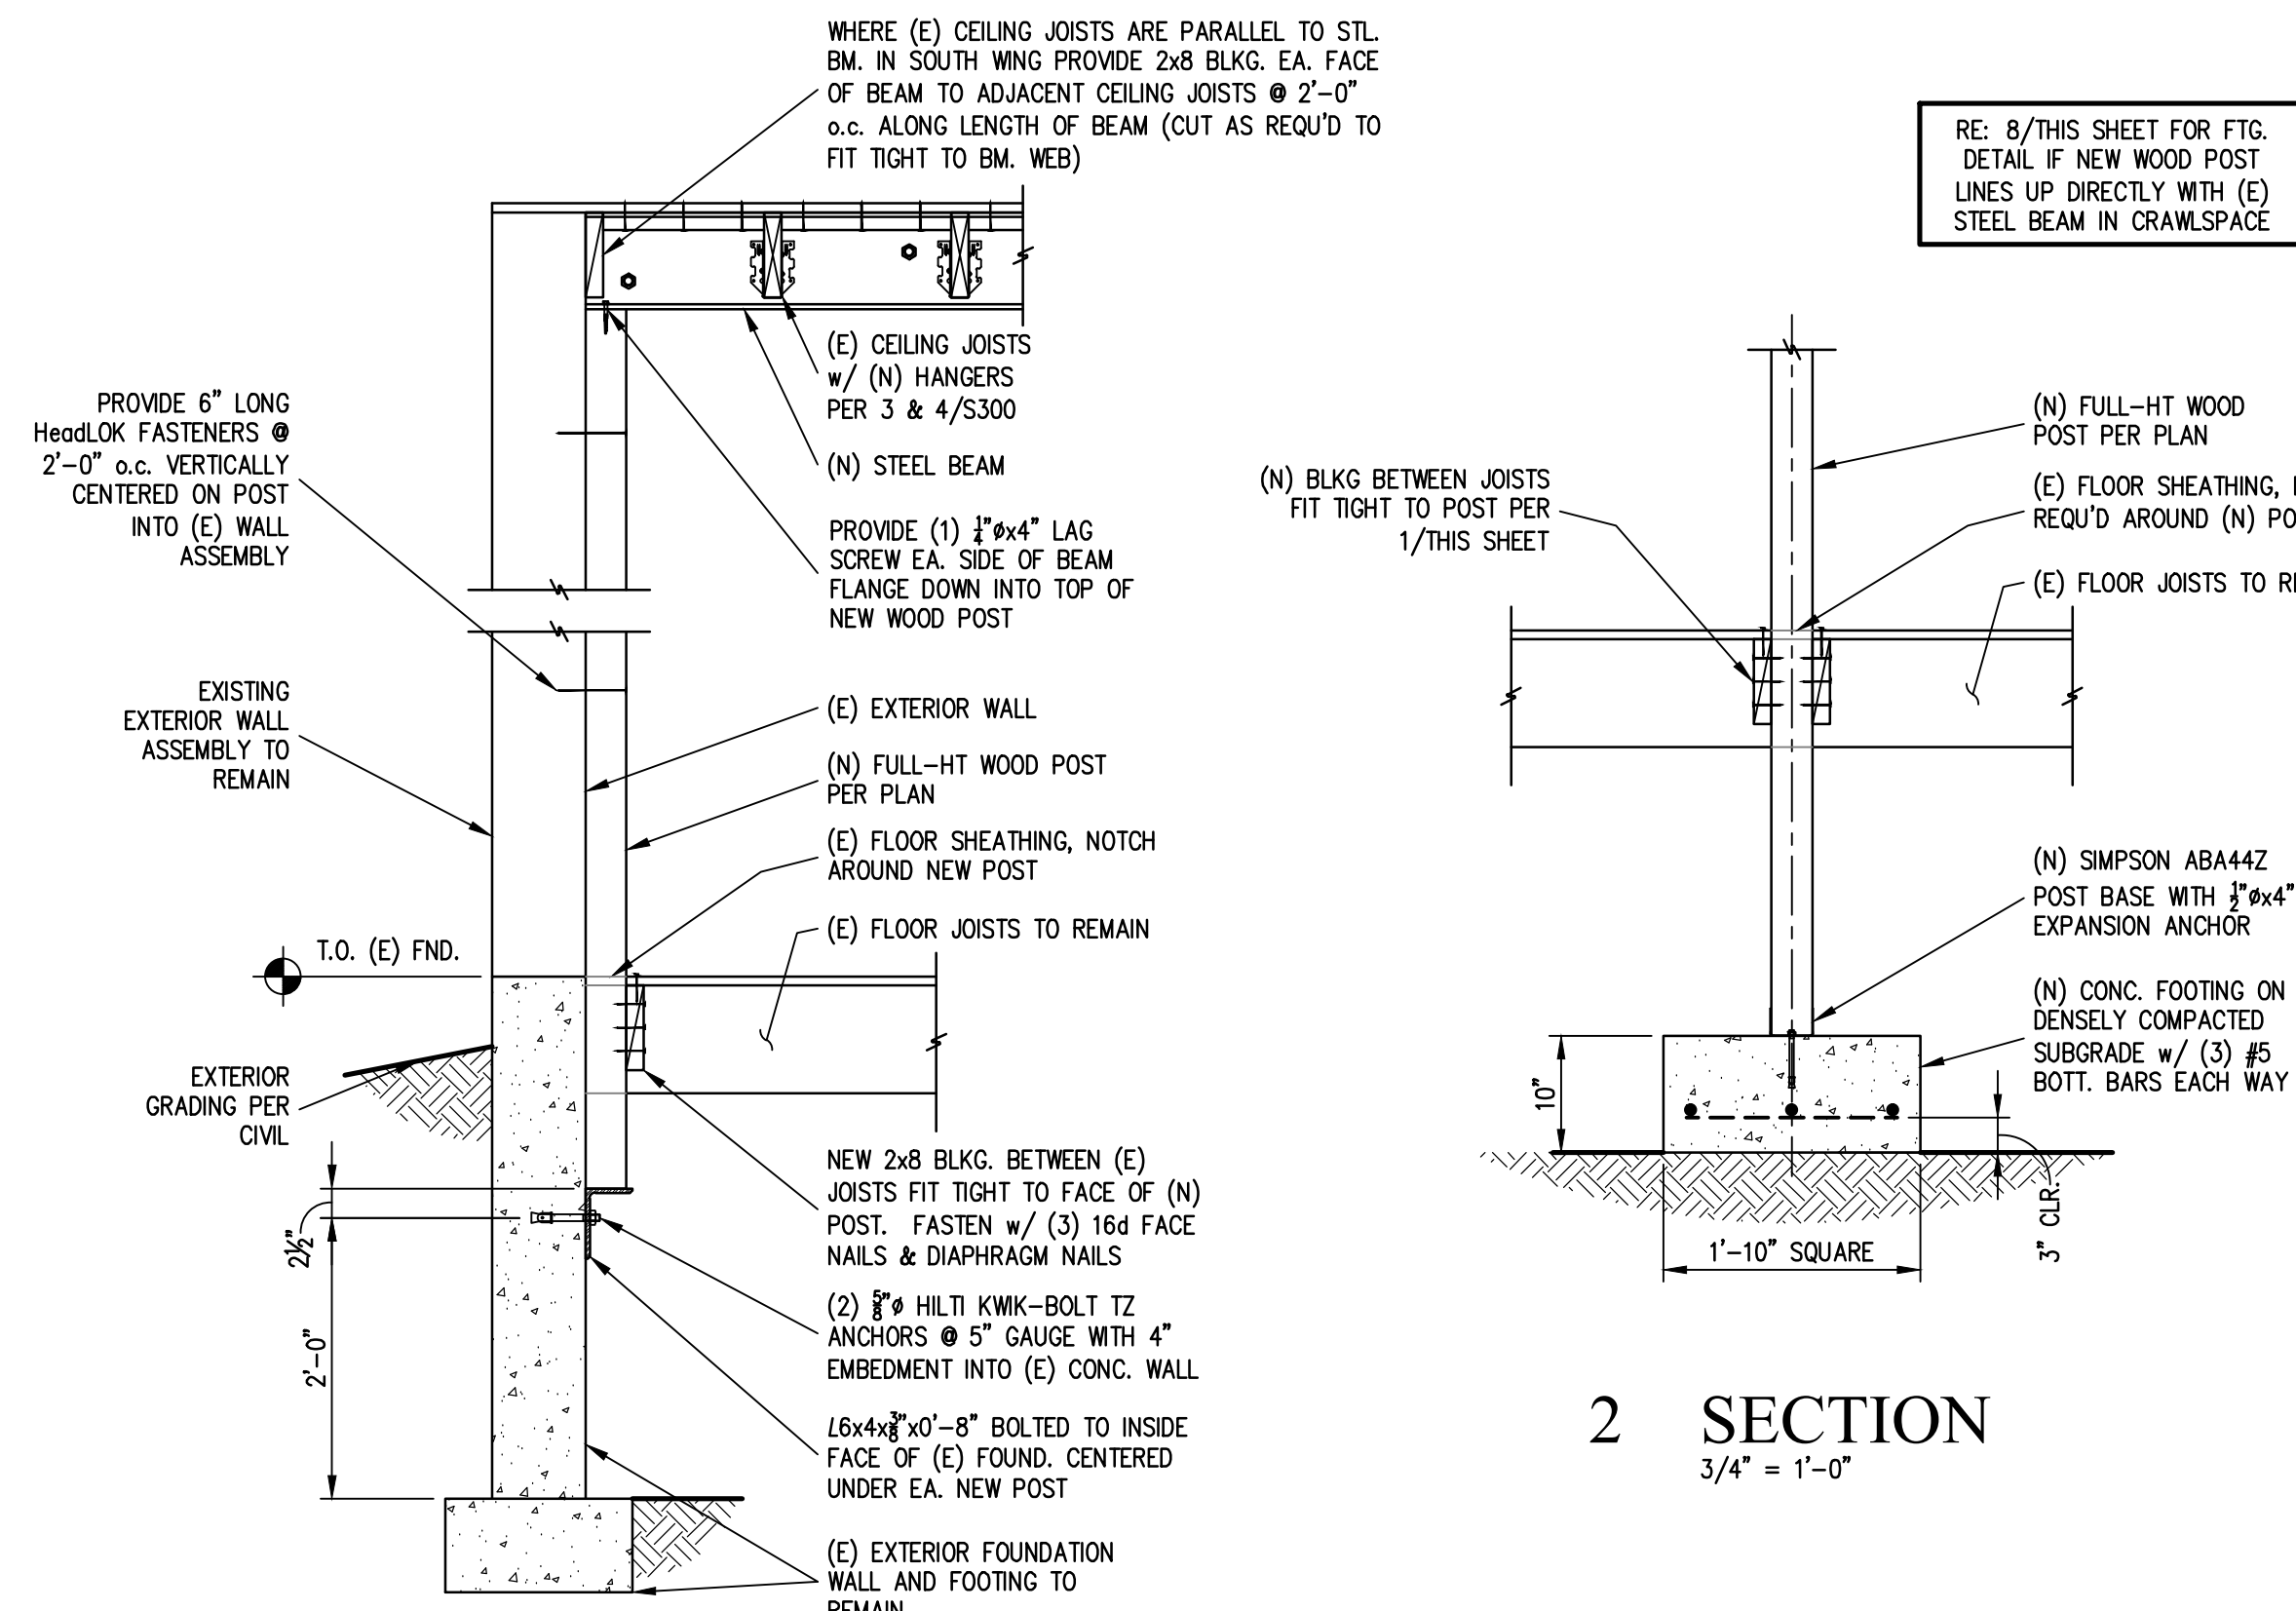

1 SECTION
3/4" = 1'-0"

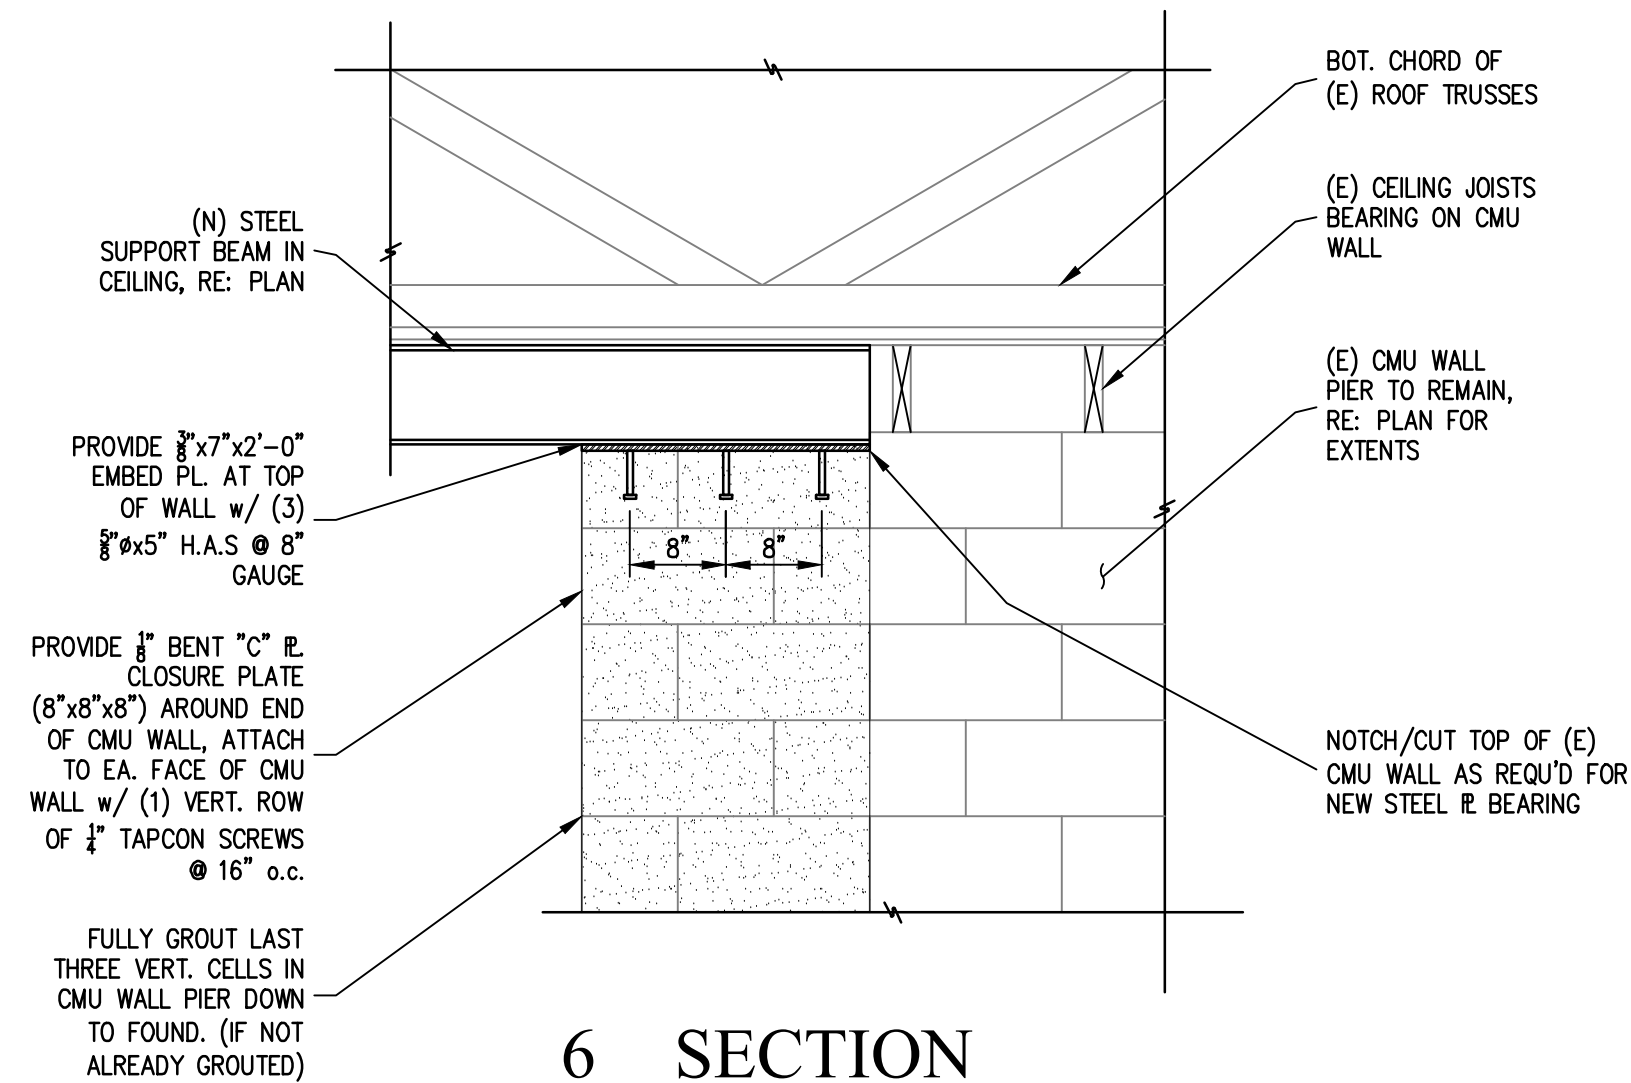


6 SECTION
3/4" = 1'-0"

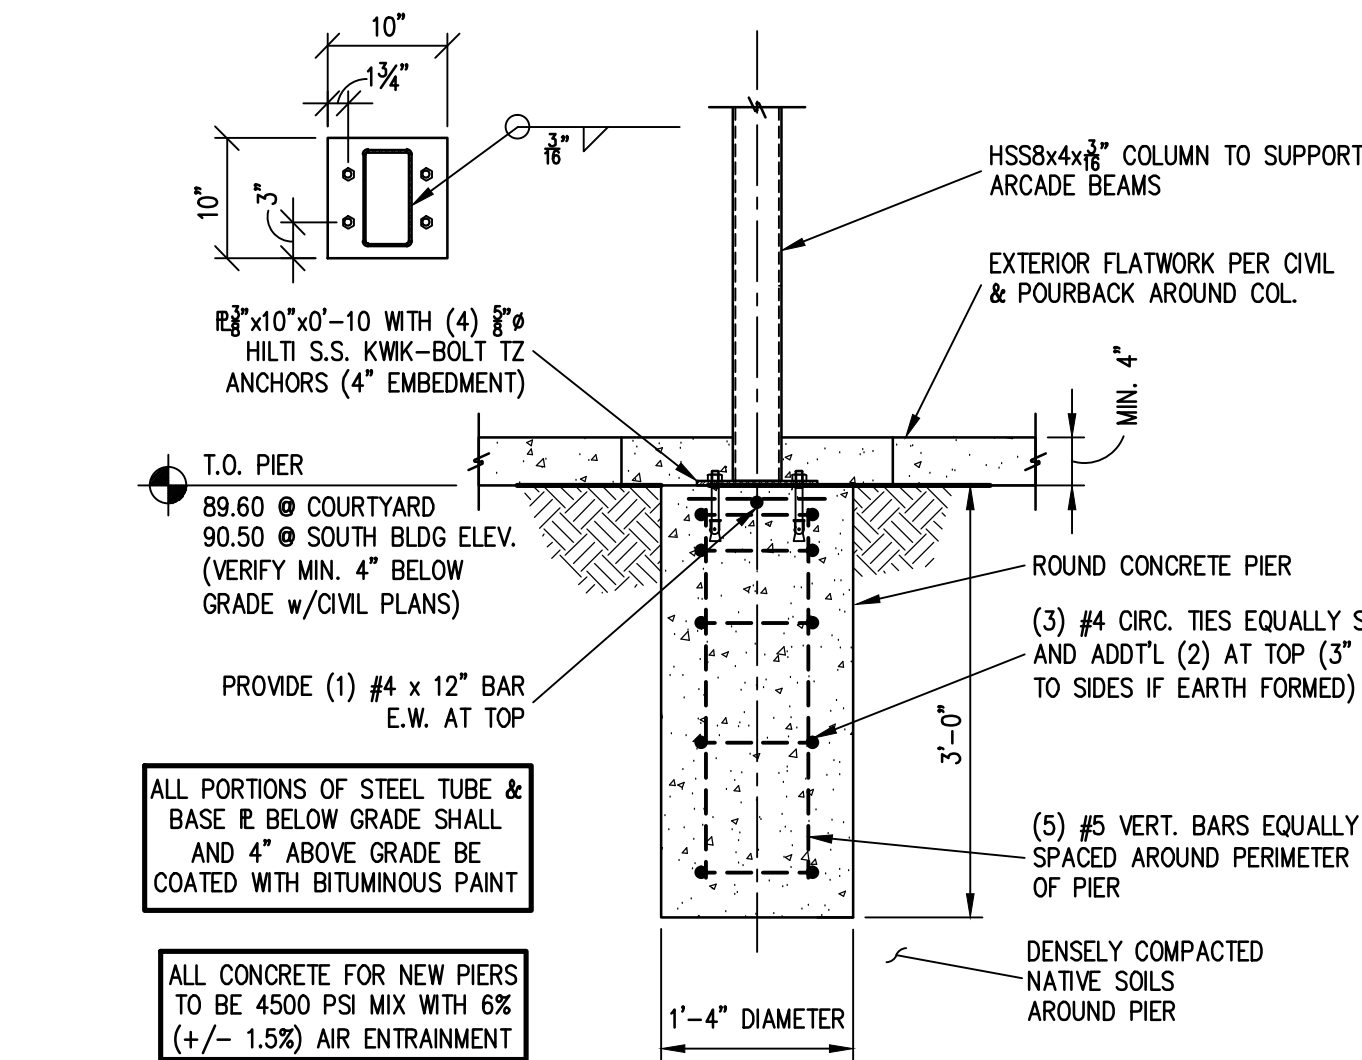


FOUNDATION AT NORTH COURTYARD & SOUTH BLDG ELEVATION COLUMNS

10 SECTION
3/4" = 1'-0"

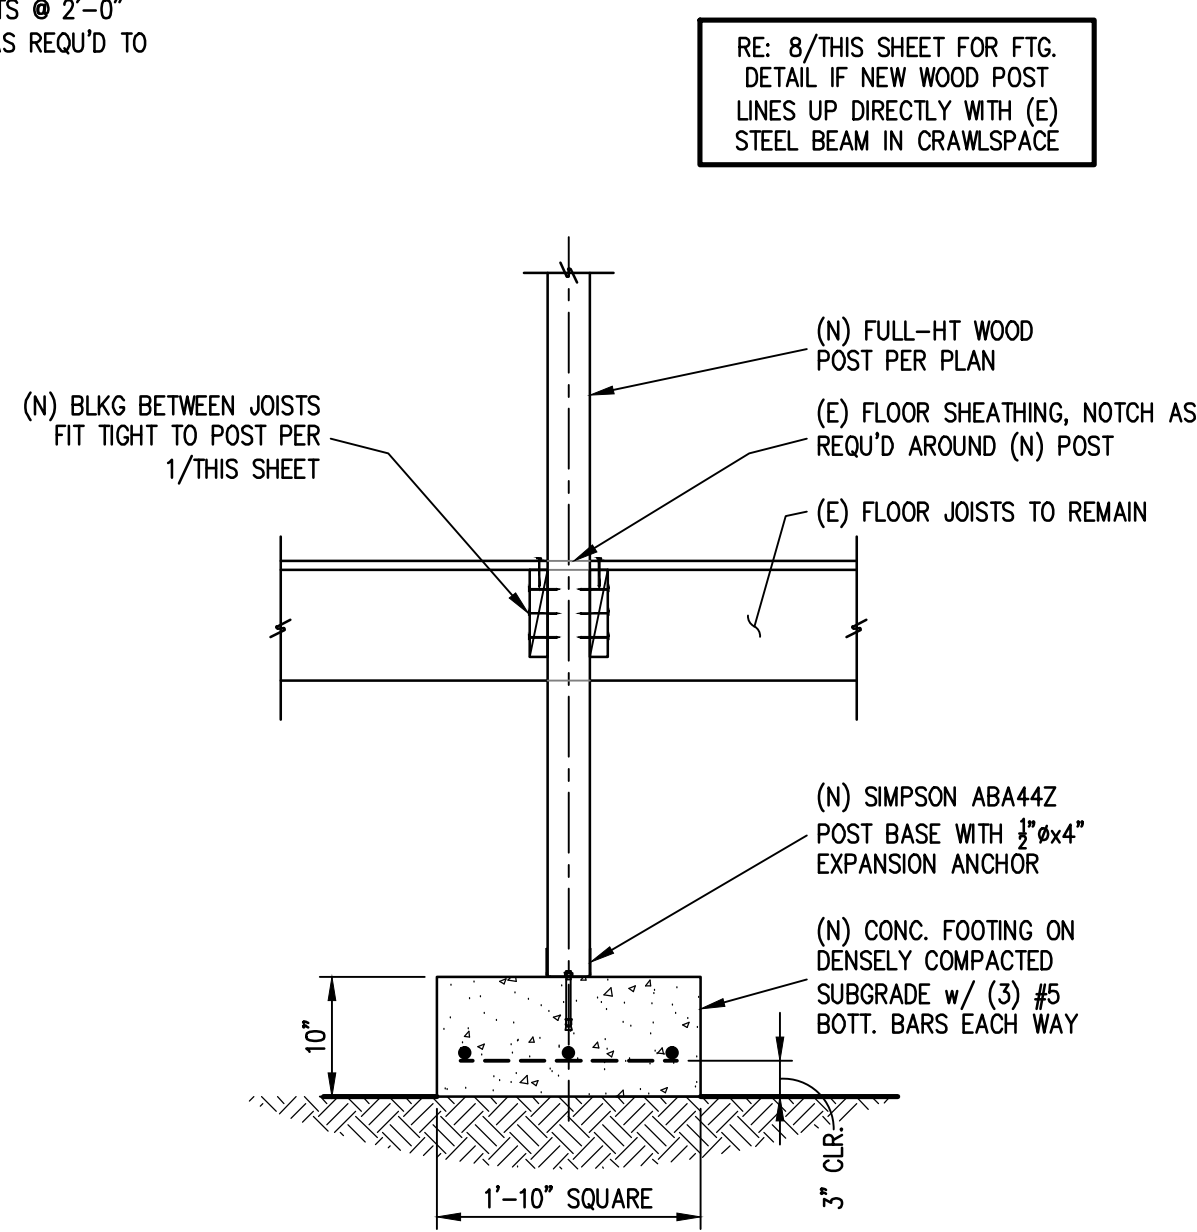


2 SECTION
3/4" = 1'-0"

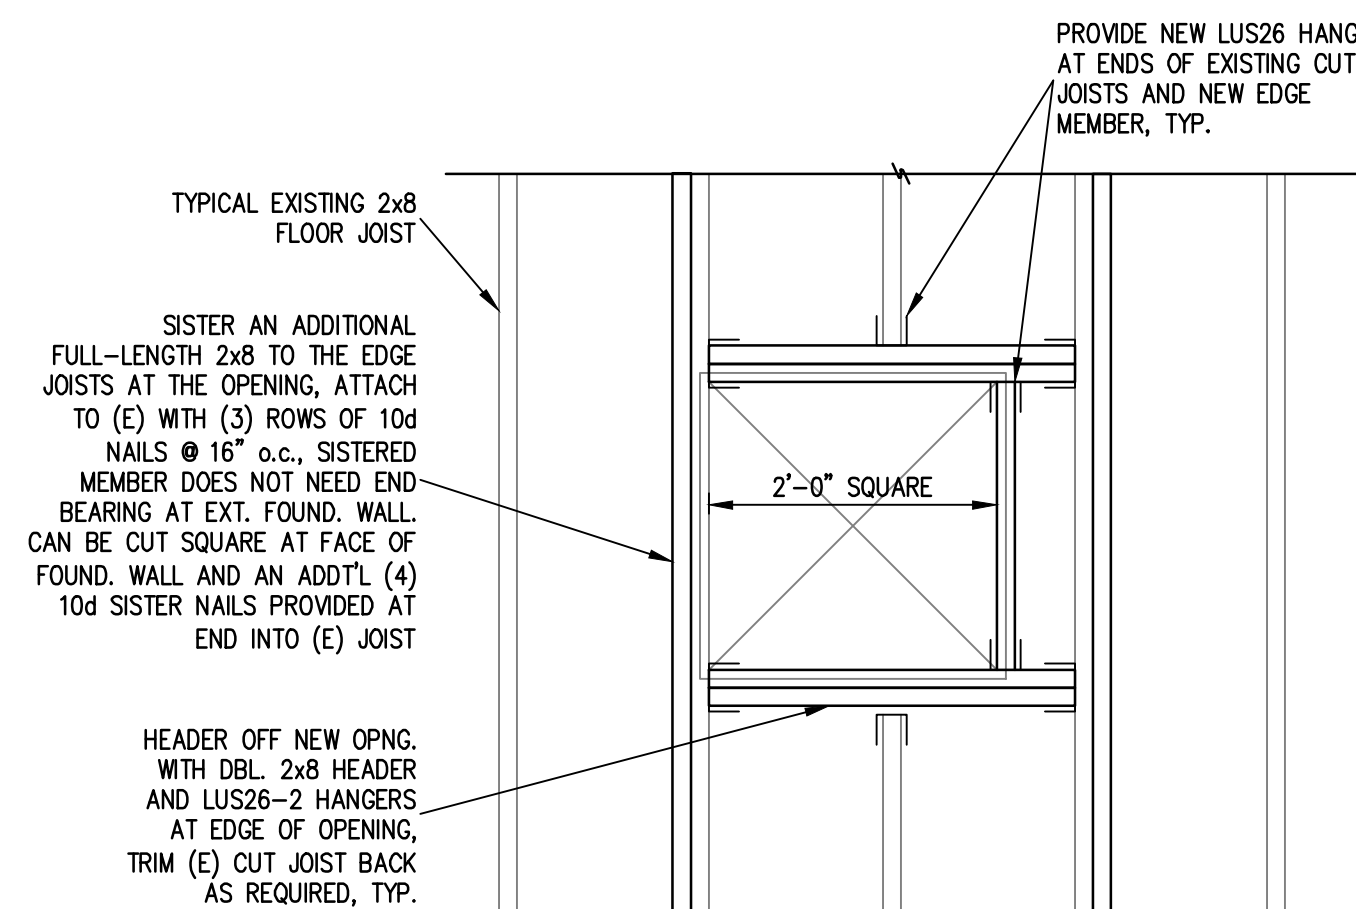


ADDITIONAL FRAMING AT NEW FLOOR OPNG.


7 SECTION
3/4" = 1'-0"

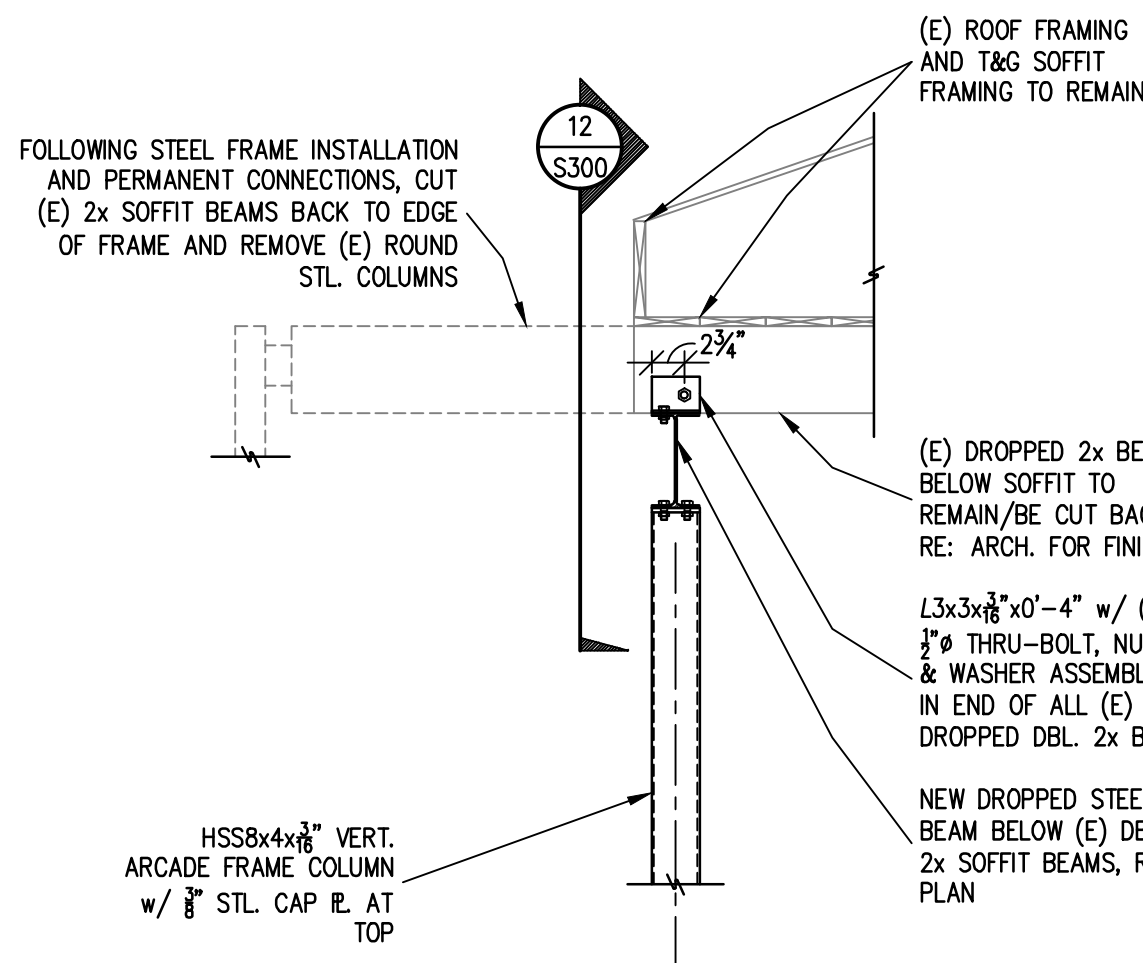


11 SECTION
3/4" = 1'-0"

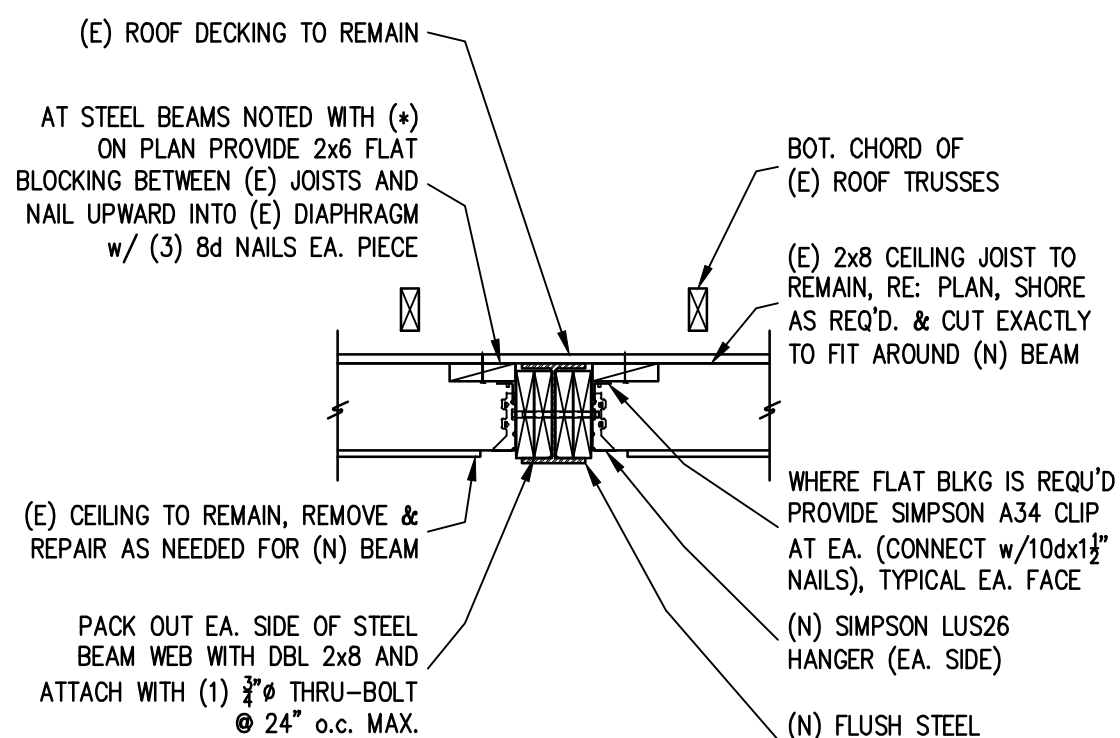


3 SECTION
3/4" = 1'-0"

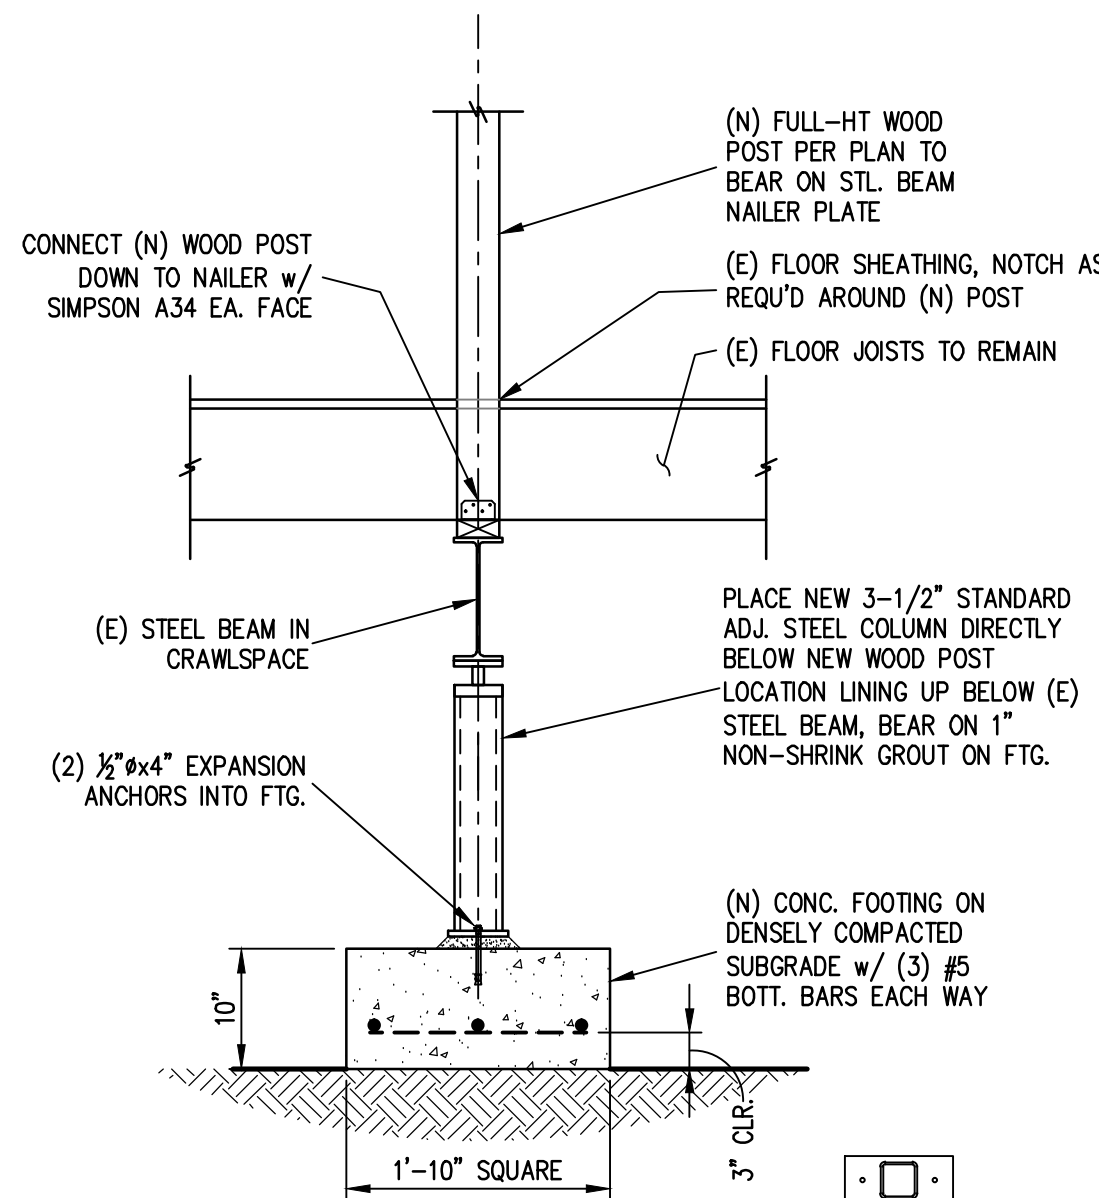


8 SECTION
3/4" = 1'-0"

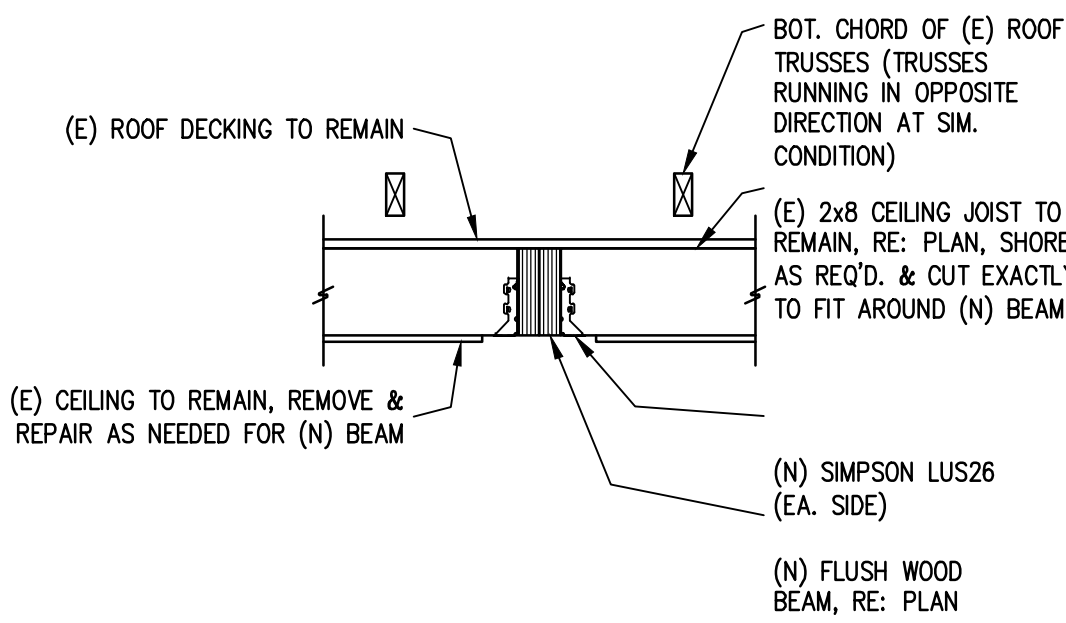

4 SECTION
3/4" = 1'-0"

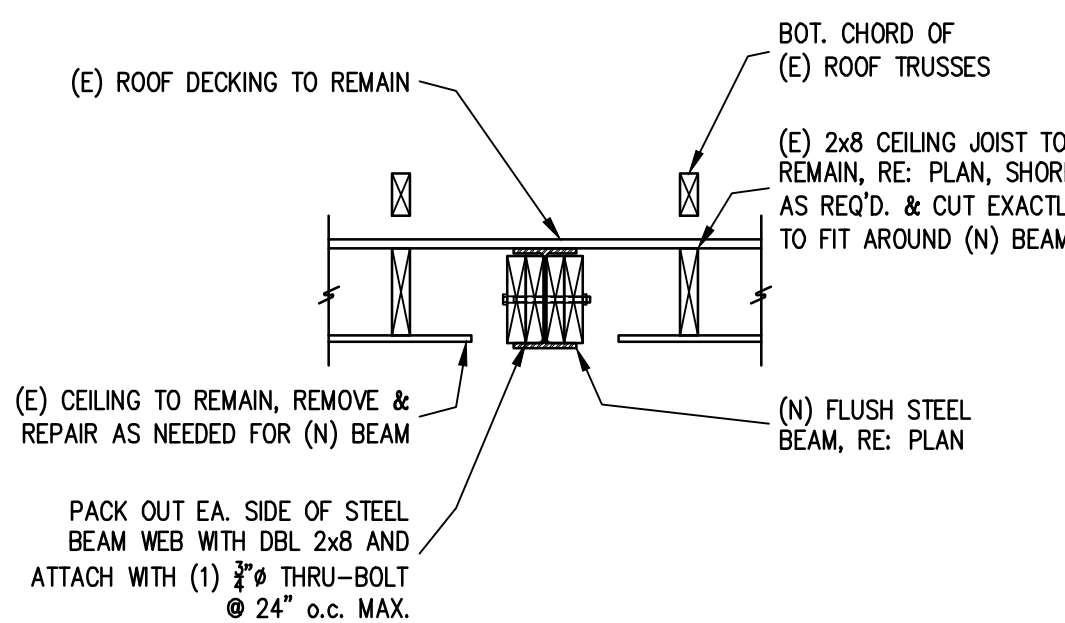


5 SECTION
3/4" = 1'-0"

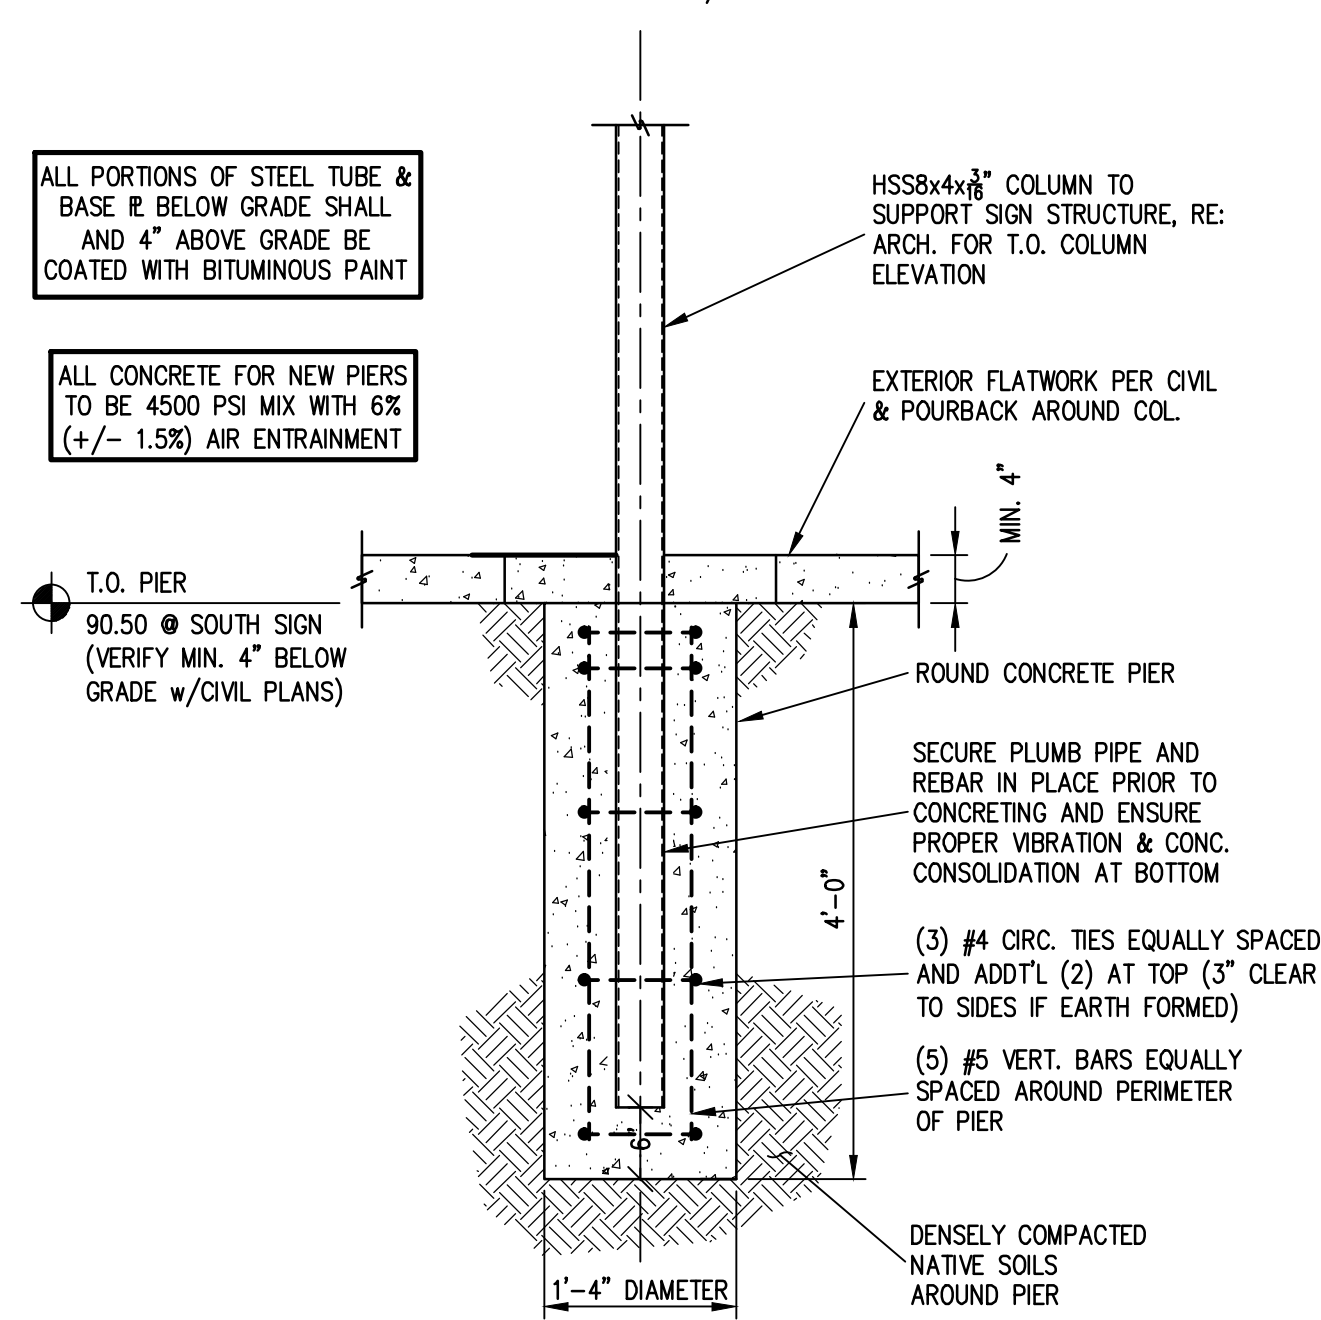

FOUNDATION AT SOUTH SIGN STRUCTURE

9 SECTION
3/4" = 1'-0"

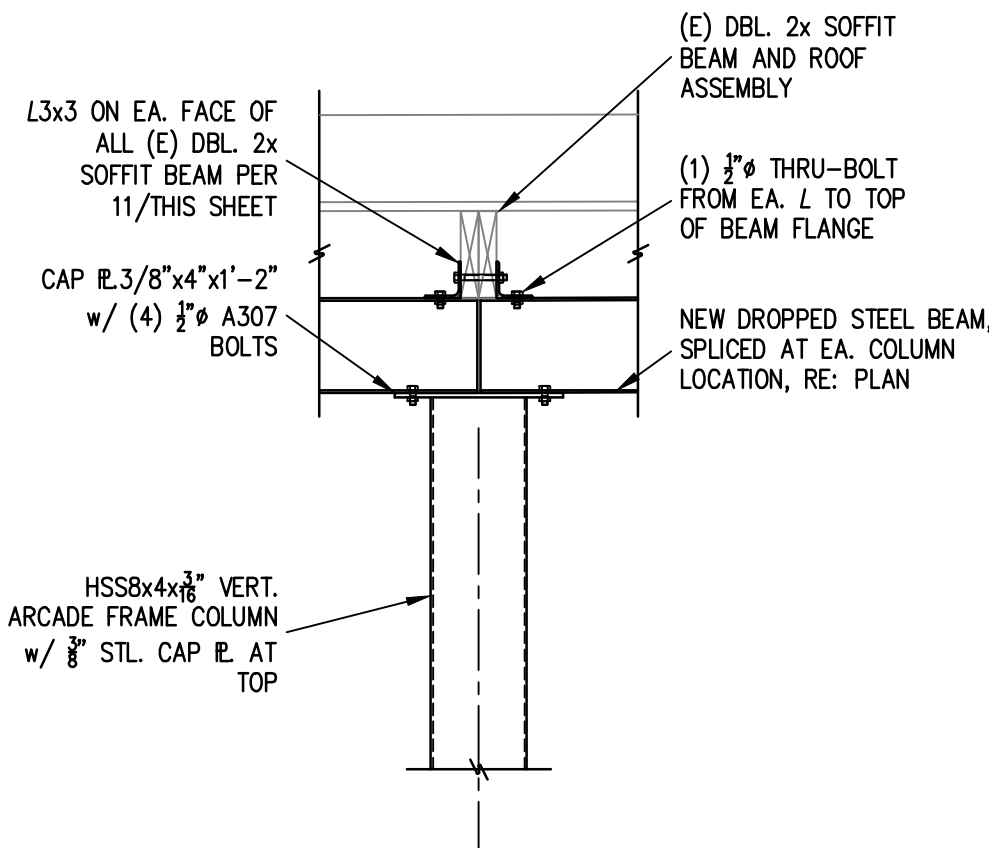

12 SECTION
3/4" = 1'-0"